

MISSISSIPPI
BOARD OF WATER COMMISSIONERS
416 North State Street
Jackson, Mississippi 39201

CODED

PRENTISS
J 88
7-26-73

WATER WELL DRILLERS LOG

7-26 1973 Bonds Well Drilling Prentiss
date well completed firm name county well located

LANDOWNER: C. R. Huddleston

description of formations encountered	depth	
	from	to
Red Lymbo	0	38
Blue Clay	38	385
Water Sand	385	430

Bonnaville, Miss

(mailing address)

WELL LOCATION:

sec. 23 T. 6 N R. 6 E
S W
8 miles South of Bonnaville
(distance) (direction) (nearest town)

WELL PURPOSE: Home
(home, irrigation, municipal, industrial)

WELL COMPLETION DATA:

- (1) diameter (inches) 4
- (2) total depth (feet) 430
- (3) static water level (feet) 130 below above top of ground.
- (4) casing Steel, 42,
(material) (depth)
_____ If telescope see back.
(size)
- (5) screen None,
(length) (depth to top)
_____ (size) (material)
- (6) pump 3/4 10,
(HP) (yield gpm)
Submersible
(type power)
- (7) electric log NO
(yes or no)
_____ (organization running log)
- (8) how well bottom plugged open


CODED

DRILLERS REMARKS:

AUG 9 1973

If well telescopes please sketch and show depths.

GROUND LEVEL

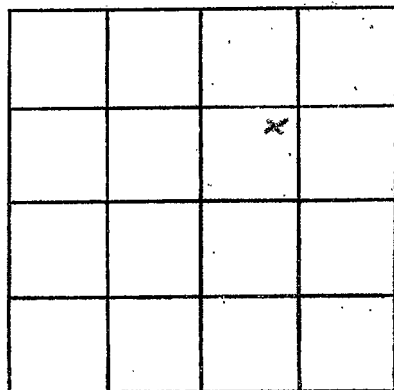

SECTION _____

Please indicate well location X.

ADDITIONAL INFORMATION

If more than one screen, show locations of each on sketch.