

PRENTISS

J 89

10-25-73

MISSISSIPPI BOARD OF WATER COMMISSIONERS  
416 North State Street  
Jackson, Mississippi 39201

CODED

WATER WELL DRILLERS LOG

Herman Homan Well & Supply, Inc.  
P. O. Box 42

Prentiss

10-25-1973  
date well completed

SHANNON, MISSISSIPPI 38668

county well located

LANDOWNER:

J.F. Roberts  
Rt 2, Baldwyn Miss  
(mailing address)

description of formations encountered

|                     | from | to  |
|---------------------|------|-----|
| Surface sand & clay | 0    | 16  |
| Blue clay           | 16   | 260 |
| Sand                | 260  | 400 |
| Bottom              | 400  |     |

WELL LOCATION:

sec. 17 T-6-N R-6-E  
S W  
3 miles N of Baldwyn  
(distance) (direction) (nearest town)

WELL PURPOSE:

Home  
(home, irrigation, municipal, industrial)

WELL COMPLETION DATA:

- (1) diameter (inches) 5"
- (2) total depth (feet) 400'
- (3) static water level (feet) 94' below top of ground
- (4) casing steel 21' 44" (material) (depth)  
5" (size) if telescope see back.
- (5) screen ND (length) (depth to top)  
(size) (material)
- (6) pump 3/4 HP 9 (type power) (yield gpm)
- (7) electric log ND (yes or no)  
(organization running log)
- (8) how well bottom plugged sealed

CODED


DRILLERS REMARKS:

NOV 20 1973

MISS. BD. OF WATER COMMISSIONERS

If well telescopes please sketch and show depths.

GROUND LEVEL

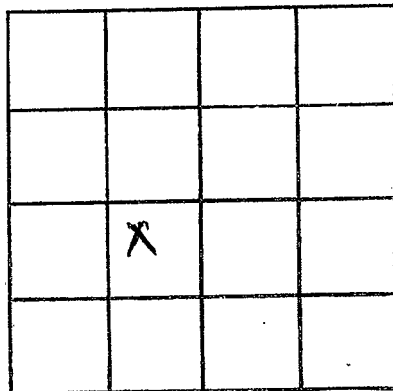

SECTION 17

Please indicate well location X.

ADDITIONAL INFORMATION

If more than one screen, show locations of each on sketch.