

Prentiss  
J92  
8-23-74

MISSISSIPPI  
BOARD OF WATER COMMISSIONERS CODED  
416 North State Street  
Jackson, Mississippi 39201

WATER WELL DRILLERS LOG

8-23 1974 Bonds Well Drilling Prentiss  
date well completed firm name county well located

LANDOWNER: O. R. Huddleston  
Booneville, Miss.  
(mailing address)

description of formations encountered	from	to
Red clay	0	40
Blue clay	40	356
Water sand	356	407

WELL LOCATION:  
sec. 23 T. 6 N. R. 6 E.  
3 miles SE of Baldwyn  
(distance) (direction) (nearest town)

WELL PURPOSE: Home  
(home, irrigation, municipal, industrial)

WELL COMPLETION DATA:

(1) diameter (inches) 4"

(2) total depth (feet) 407'

(3) static water level (feet) 120 <sup>below</sup> top of ground.

(4) casing Steel, 43' 5"  
(material) (depth)

(size) if telescope see back.

(5) screen None  
(length) (depth to top)

(size) (material)

(6) pump 3/4 10  
(HP) (yield gpm)

Sub  
(type power)

(7) electric log NO  
(yes or no)

(organization running log)

(8) how well bottom plugged open


DRILLERS REMARKS:

RECEIVED  
OCT - 1 1974

MISS. BD. OF WATER COMME

If well telescopes please sketch and show depths.

GROUND LEVEL

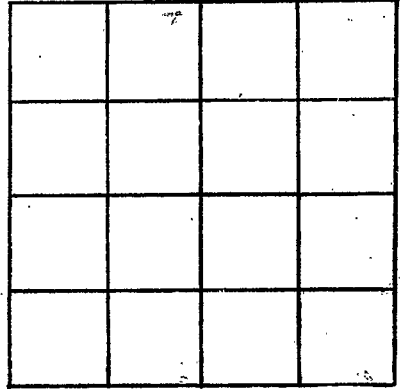

SECTION \_\_\_\_\_

Please indicate well location X.

ADDITIONAL INFORMATION

If more than one screen, show locations of each on sketch.