

MISSISSIPPI DEPARTMENT OF ENVIRONMENTAL QUALITY

Office of Land and Water Resources

P. O. Box 10631
Jackson, MS 39289-0631

WATER WELL DRILLERS LOG

COUNTY WELL LOCATED PRENTISS	
WELL NUMBER 93	CODING <input checked="" type="checkbox"/>
DATE WELL COMPLETED JUNE, 1994	

PERMIT NUMBER 14514
NAME OF DRILLING FIRM J.W. WEBB & Sons, INC
BELDEN, MS.

NAME & MAILING ADDRESS OF LANDOWNER INGRAM WATER ASSOC, INC	
P.O. Box 28	
BALDWIN, MS, 38824	
WELL LOCATION: SEC	TOWNSHIP RANGE
33	6 N 6 E
DISTANCE	DIRECTION
3 Miles	WEST of BALDWIN
OTHER LANDMARK	
WELL PURPOSE: Home, Irrigation, Municipal, Industrial, Fish Pond, etc. MUNICIPAL	

PUMP DATA		
PUMP TYPE (Circle One): Submersible, Turbine , Jet, Flowing Well, Other (Describe) _____		
POWER TYPE (Circle One): Electric , Tractor, Diesel, Gasoline, Butane, Other (Describe) _____ H/P _____		
Pump Capacity (GPM) 300	No. of Stages 8	Setting Depth 280 FT.
PUMP TEST		
Well yielded 313 GPM with a drawdown of 69 ft. after 24 hours of pumping		

WELL DATA		
Well Depth 566'	Casing Diameter (In.) 12"	Casing Length (Ft.) 491
Type of Casing STEEL	Hole Depth 493'	Depth to Static Water Level 165'
TYPE OF COMPLETION: (Circle One or More): Gravel Packed , Underreamed , Telescoped, Natural Development, Open Hole, Other (Describe) _____		
WELL GROUTED TO A DEPTH OF 491 FEET Type Grout (circle one): Cement , Bentonite, or Mix		

LOG DATA	
TYPE OF LOG RUN (Circle One): Electric , Gamma Ray, Density, Sonic, Neutron, Other (Describe) _____	
Name of Organization Running Log M-B-O-G	

SCREEN DATA		
Diameter - Inches 6"	Length - Feet 60	Slot Size - Inches .020
Screen, Type 304 SS	Depth to Bottom - Feet 566'	


GEOLOGIC DATA (Office Use Only)			
Surface Elev.	Geologic Unit	Unit Thickness	Depth to Top
Subs. SWL	Date	Analysis	Aquifer Test
Driller's Remarks LAP PIPE 8" Top of Lap Pipe or Reduction in Casing 426 FEET			
IF TELESCOPED OR MORE THAN ONE SCREEN: USE BACK PAGE			

DESCRIPTION OF FORMATIONS ENCOUNTERED	FROM	TO	FORMATIONS (Continued)	FROM	TO
RED CLAY	0	10'	RECEIVED OCT 17 1994 Dept. of Environmental Quality Office of Land & Water Resources		
BLUE CLAY	10'	120'			
SAND, STREAKS OF CLAY	120	270			
SAND & CLAY	270	2400			
SAND	400	570			
SANDY CLAY	570	620			

IF MORE SPACE IS NEEDED, USE BACK

If well telescopes please sketch and show depths.

GROUND LEVEL

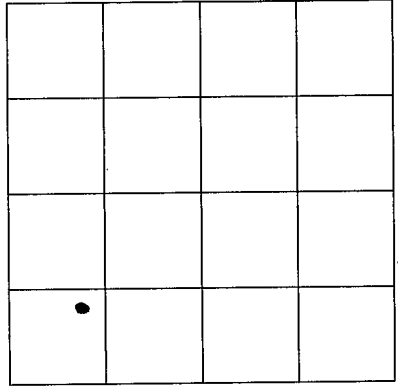

SECTION 33

Please indicate well location X.

ADDITIONAL INFORMATION

If more than one screen,
show location of each on sketch.