

PRENTISS WATER WELL DRILLERS LOG

J 302

Herndon Well & Supply Co.

Date: Nov 21, 1960, Driller:

SHANNON, MISS.

County Prentiss

11-2-60

(Name)

(1) Owner of Land: B. E. Niblett
(Name)

Rt 1 Baldwyn, Miss
(Address)

(2) Location: 1/4, 1/4, Sec 13 T6R6

2 miles South, of Franktown
(distance) (direction) (Nearest Town)

(3) Topography: Hilly
(Hilly) (Flat) (Level)

(4) Purpose of Well: Home use
(Domestic Irrigation
Municipal, Industrial, Other)

Description & Color of Materials
Sand, Clay, Red Clay, Shell, etc.

Thick-
ness
Feet

Depth
Feet

Sand & Clay

25

Blue Rock

Sand

230

Bottom

340

Information upon completion of well:

(1) Diameter 4 inches.

(2) Total Depth 340 feet.

(3) Water Level 50 feet below top of ground.

(4) Cased to 29' 6", Size 4"

(5) Screen: Size , Length


(6) Were any formations sealed against pollution?

X yes, no.

If YES depth of formation 25 ft

Why Surface & Sand

Drillers Remarks:

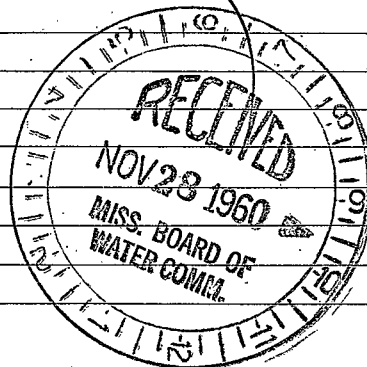

(Use Back Side)

Well No.

1870
1871
1872
1870

1901
1902
1903
1950