

PRENTISS

J 304

J 2000
6-20-60

WATER WELL DRILLERS LOG

HERNDON WELL & SUPPLY CO.

Date: June 20, 1960, Driller: SHANNON, (Name) P. O. BOX 42 County Prentiss

	Description & Color of Materials Sand, Clay, Red Clay, Shell, etc.	Thick- ness Feet	Depth Feet
(1) Owner of Land: <u>Finnon L. Kins</u> <u>Co. (Contractor) Tupula, Miss</u> (Name) (Address)	<u>surface sand</u> <u>& clay</u>		<u>0</u>
(2) Location: <u>1/4, 1/4, Sec. 13 T6 R6E</u> <u>1</u> miles <u>South</u> of <u>Frankston</u> (distance) (direction) (Nearest Town)	<u>Blue clay</u> <u>to</u> <u>sand</u>		<u>40</u> <u>240</u>
(3) Topography: <u>Hilly</u> (Hilly) (Flat) (Level)	<u>to</u> <u>Bottom</u>		<u>360</u>
(4) Purpose of Well: <u>Domestic</u> (Domestic Irrigation Municipal, Industrial, Other)			


Information upon completion of well:

- (1) Diameter 4 inches.
- (2) Total Depth 360 feet.
- (3) Water Level 70 feet below top of ground.
- (4) Cased to 14' 5", Size 4"
- (5) Screen: Size , Length
- (6) Were any formations sealed against pollution?
✓ yes, no.

If YES depth of formation 40 ft

Why Basin & Sand

Drillers Remarks:

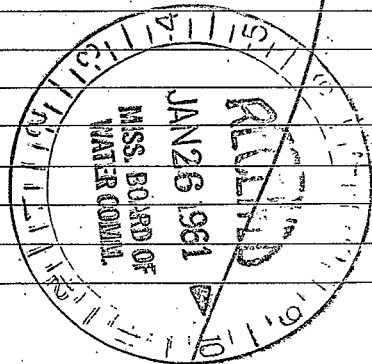

Well No.

