

PRENTISS MISSISSIPPI BOARD OF WATER COMMISSIONERS

J 2001
7-13-60

J300

WATER WELL DRILLERS LOG

Herndon Well & Supply Co.

Prentiss

Date: July 13, 1960, Driller: SHANNON, MISS. County: ~~Prentiss~~

(Name)

(1) Owner of Land: Lesley Cox
(Name)
At. 1 Balderson, Miss
(Address)

(2) Location: 1/4, 1/4, Sec. 17 T6R6
5 miles West, of Frankston
(distance) (direction) (Nearest Town)

(3) Topography: FLAT
(Hilly) (Flat) (Level)

(4) Purpose of Well: Home Use
(Domestic Irrigation
Municipal, Industrial, Other)

Description & Color of Materials Sand, Clay, Red Clay, Shell, etc.	Thick- ness Feet	Depth Feet
Sand & Clay	2	42
Blue Rock	42	42
Hard Rock	3	45
Bottom	3	48
Blue Rock	2	50
AND Sand	3	50
SAND &	3	50
Hard Rock	3	52
SAND	3	52
BOTTOM	3	52


Information upon completion of well:

- (1) Diameter 4 inches.
- (2) Total Depth 378 feet.
- (3) Water Level 115 feet below top of ground.
- (4) Cased to 42 ft Size 4"
- (5) Screen: Size , Length .
- (6) Were any formations sealed against pollution?

yes, no.

If YES depth of formation 42 ft
Why Surface

Drillers Remarks: drop pipe
150 ft

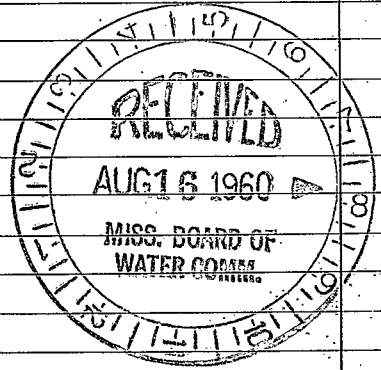

Well No.
J300

(Use Back Side)

[The page contains extremely faint and illegible text, likely bleed-through from the reverse side of the document. The text is scattered across the page and does not form any recognizable words or sentences.]