

PRENTISS

J 2002
4-20-61

J 303

WATER WELL DRILLERS LOG

HERNDON WELL & SUPPLY CO

Date: April 20 19 61, Driller: Prentiss County

P. O. BOX 42

SHANNON, MISSISSIPPI

- (1) Owner of Land: Jas Morgan
(Name)
Baldwyn, Miss
(Address)
- (2) Location: 1/4, 1/4, Sec. 14-65 T 6E R 6E
4 miles N, of Baldwyn
(distance) (direction) (Nearest Town)
- (3) Topography: Hilly
(Hilly) (Flat) (Level)
- (4) Purpose of Well: Home use
(Domestic Irrigation
Municipal, Industrial, Other)

Description & Color of Materials Sand, Clay, Red Clay, Shell, etc.	Thick- ness Feet	Depth Feet
Surface sand		0
& clay		19
Blue rock		
&		
sand		160
&		
Bottom		280


Information upon completion of well:

- (1) Diameter 4 inches.
- (2) Total Depth 280 feet.
- (3) Water Level 60 feet below top of ground.
- (4) Cased to 22' 1", Size 4"
- (5) Screen: Size , Length .
- (6) Were any formations sealed against pollution?
 yes, no.

If YES depth of formation 15'

Why Surface & sand

Drillers Remarks:

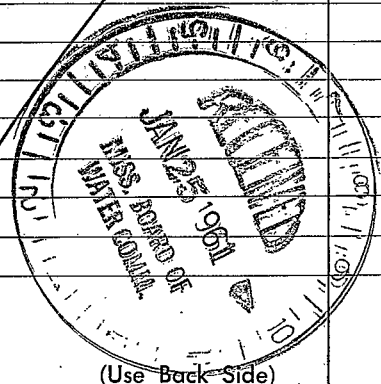

(Use Back Side)

Well No.

