

~~Permits~~ MISSISSIPPI BOARD OF WATER COMMISSIONERS

2003

1-16-62

WATER WELL DRILLERS LOG

D302  
PRENTISS  
See

Date: 1-16, 1962, Driller: C. C. Webb County: See  
(Name)

(1) Owner of Land: Tom Rauer  
(Name)  
Baldwyn miss  
(Address)

(2) Location: 1/4, 1/4, Sec. 13 T6R6E  
3 miles north of Baldwyn  
(distance) (direction) (Nearest Town)

(3) Topography: ✓  
(Hilly) (Flat) (Level)

(4) Purpose of Well: ✓  
(Domestic Irrigation) (Municipal, Industrial, Other)

Description & Color of Materials Sand, Clay, Red Clay, Shell, etc.	Thick- ness Feet	Depth Feet
soil to 11ft clay		
to 20ft blue mud		
to 175ft 2ft		
sand rock 177		
ft to 250ft water		
sand cappel sand		

Information upon completion of well:

(1) Diameter 4 inches.

(2) Total Depth 250 feet.

(3) Water Level 100 feet below top of ground.

(4) Cased to 23, Size 4'


(5) Screen: Size 6, Length 0

(6) Were any formations sealed against pollution?  
\_\_\_\_\_ yes, 0 no.

If YES depth of formation \_\_\_\_\_  
Why \_\_\_\_\_

Drillers Remarks: \_\_\_\_\_

Doubtful location  
43

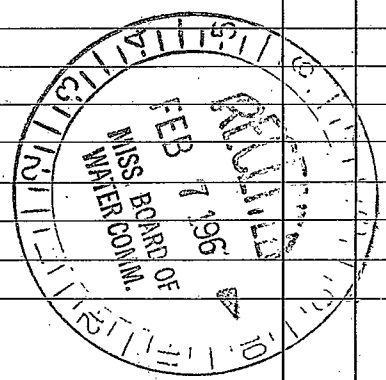

(Use Back Side)

Well No.

Tom Long 1854