

LEE Mont
J 2004
4-24-62

MISSISSIPPI BOARD OF WATER COMMISSIONERS

WATER WELL DRILLERS LOG

Date: 4-24, 1962, Driller: O. C. Webb, County: Prentiss

(1) Owner of Land: Bernie Ray Bishop
(Name)

(Address)

(2) Location: $\frac{1}{4}$, $\frac{1}{4}$, Sec. 32 T6 R6
2 1/2 miles West of Baldwyn
(distance) (direction) (Nearest Town)

(3) Topography: _____
(Hilly) (Flat) (Level)

(4) Purpose of Well: _____
(Domestic Irrigation
Municipal, Industrial, Other)

Description & Color of Materials Sand, Clay, Red Clay, Shell, etc.	Thick- ness Feet	Depth Feet
soil. to 6 ft		
white rock to		
15 ft blue rock		
to 160 ft water		
rock 1 ft water		
sand to 250 ft		


Information upon completion of well:

(1) Diameter 4 inches.
(2) Total Depth 250 feet.
(3) Water Level 89 feet below top of ground.
(4) Cased to 17 ft, Size 4"
(5) Screen: Size _____, Length _____
(6) Were any formations sealed against pollution?
_____ yes, 0 no.

If YES depth of formation _____
Why _____

Drillers Remarks: _____

18

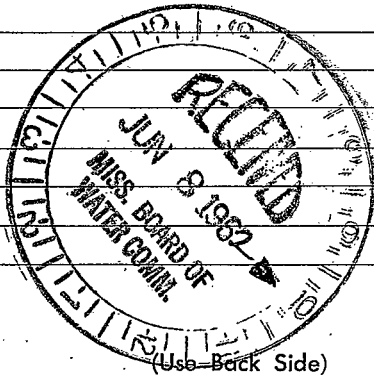

Well No.

