

PRENTISS MISSISSIPPI BOARD OF WATER COMMISSIONERS

J 2005  
6-5-62

WATER WELL DRILLERS LOG

HERNDON WELL & SUPPLY CO.

Date: August 5, 1962, Driller: P. O. BOX 42 County: Prentiss  
SHANNON, MISSISSIPPI

(1) Owner of Land: Curtis Greenhalgh  
(Name)  
At Baldwyn, Miss.  
(Address)

(2) Location: 1/4, 1/4, Sec. 8, T. 65, R. 6E  
1 miles — of Coahoma,  
(distance) (direction) (Nearest Town)

(3) Topography: Flat  
(Hilly) (Flat) (Level)

(4) Purpose of Well: Domestic  
(Domestic Irrigation, Municipal, Industrial, Other)

Description & Color of Materials Sand, Clay, Red Clay, Shell, etc.	Thick- ness Feet	Depth Feet
<u>fine sand &amp; clay</u>		<u>0</u>
<u>Blue sand</u>		<u>15</u>
<u>Sand</u>		<u>240</u>
<u>Bottom</u>		<u>360</u>

Information upon completion of well:

(1) Diameter 4 inches.

(2) Total Depth 360 feet.

(3) Water Level 100' feet below top of ground.

(4) Cased to 19' 10", Size 4".


(5) Screen: Size —, Length —.

(6) Were any formations sealed against pollution?  
— yes, — no.

If YES depth of formation 15'

Why fine sand & gravel

Drillers Remarks:

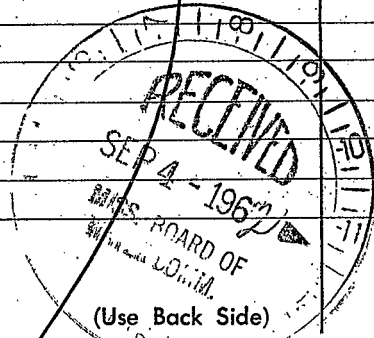

Well No.

[The page contains extremely faint and illegible text, likely bleed-through from the reverse side of the document. The text is scattered across the page and does not form any recognizable words or sentences.]