

PRENTISS

A J 2001

3-29-63

WATER WELL DRILLERS LOG

HERNDON WELL & SUPPLY CO.

Date: March 29 1963, Driller: P.O. BOX 42 County: Prentiss  
SHANNON, MISSISSIPPI



	Description & Color of Materials Sand, Clay, Red Clay, Shell, etc.	Thick- ness Feet	Depth Feet
(1) Owner of Land: <u>C.A. Morris</u> (Name) <u>Rt 2 Baldwyn, Miss</u> (Address)	<u>surface sand</u>		<u>0</u>
(2) Location: <u>1/4, 1/4, Sec. 10 T. 65 N. R. 1 E.</u> <u>2 1/2 miles W</u> , of <u>Frankston</u> (distance) (direction) (Nearest Town)	<u>1 1/2 clay</u> <u>to</u> <u>blue sand</u> <u>to</u> <u>sand</u>		<u>18</u>  <u>240</u>
(3) Topography: <u>Flat</u> (Hilly) (Flat) (Level)	<u>to</u> <u>bottom</u>		<u>360</u>
(4) Purpose of Well: <u>Domestic</u> (Domestic Irrigation Municipal, Industrial, Other)			


Information upon completion of well:

- (1) Diameter 4 inches.
- (2) Total Depth 360 feet.
- (3) Water Level 90 feet below top of ground.
- (4) Cased to 21', Size 4".
- (5) Screen: Size \_\_\_\_\_, Length \_\_\_\_\_.
- (6) Were any formations sealed against pollution?  
yes, \_\_\_\_\_ no.

If YES depth of formation 18'

Why surface & sand

Drillers Remarks: \_\_\_\_\_

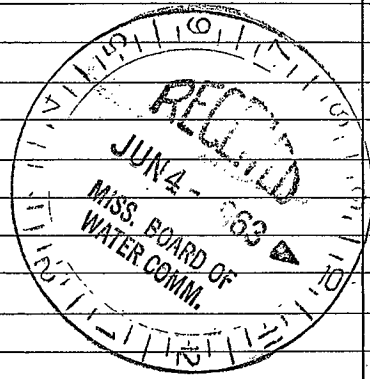

Well No.

(Use Back Side)

