

PRENTISS
J 2008
3-15-63

WATER WELL DRILLERS LOG

HERNDON WELL & SUPPLY CO.

Date: March 12, 1963 Driller: HERNDON WELL & SUPPLY CO. County: Prentiss
P.O. BOX 42
SHANNON, MISSISSIPPI

(1) Owner of Land: Ervin Henderson
(Name)
Box 2 Ballays, Miss
(Address)

(2) Location: 1/4, 1/4, Sec 10 T 65 R 6E
1/2 miles W, of Frankston
(distance) (direction) (Nearest Town)

(3) Topography: Flat
(Hilly) (Flat) (Level)

(4) Purpose of Well: Domestic
(Domestic Irrigation
Municipal, Industrial, Other)

Description & Color of Materials Sand, Clay, Red Clay, Shell, etc.	Thick- ness Feet	Depth Feet
<u>Surface sand</u>		<u>0</u>
<u>& clay</u>		
<u>Shale</u>		<u>18</u>
<u>sand</u>		<u>180</u>
<u>Bottom</u>		<u>300</u>

Information upon completion of well:

(1) Diameter 4 inches.

(2) Total Depth 300 feet.

(3) Water Level 50 feet below top of ground.

(4) Cased to 21' 7", Size 4"


(5) Screen: Size —, Length —

(6) Were any formations sealed against pollution?
yes, no.

If YES depth of formation 18 ft.

Why surface & sand

Drillers Remarks:

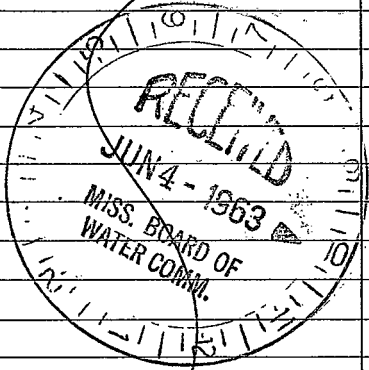

(Use Back Side)

Well No.

1952

1953

1954

1966