

J 200
6-12-63

WATER WELL DRILLERS LOG

HERNDON WELL & SUPPLY CO.

Date: 6-12, 1963, Driller:

P. O. BOX 42

SHANNON (Name)

MISSISSIPPI County

Prentiss


(1) Owner of Land: Maxia Steel
(Name)
At 1 Baldwyn, Miss
(Address)
(2) Location: 1/4, 1/4, Sec. 19 65 E
8 miles W, of Baldwyn
(distance) (direction) (Nearest Town)
(3) Topography: Hilly
(Hilly) (Flat) (Level)
(4) Purpose of Well: Domestic
(Domestic Irrigation
Municipal, Industrial, Other)

Description & Color of Materials Sand, Clay, Red Clay, Shell, etc.	Thick- ness Feet	Depth Feet
<u>Surface sand & clay</u>		<u>0</u>
<u>Blue shale</u>		<u>24</u>
<u>Ground</u>		<u>240</u>
<u>Bottom</u>		<u>460</u>

Information upon completion of well:

(1) Diameter 5 inches.
(2) Total Depth 460 feet.
(3) Water Level 130 feet below top of ground.
(4) Cased to 41', Size 5"
(5) Screen: Size ✓, Length ✓
(6) Were any formations sealed against pollution?
✓ yes, no.

If YES depth of formation 38'
Why surface & sand
Drillers Remarks:

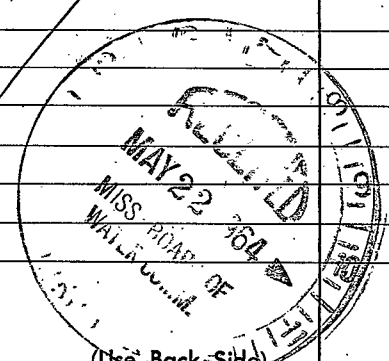

Well No.

