

J 2011

7-29-65

WATER WELL DRILLERS LOG

Herndon-Homan Well & Supply, Inc.

P. O. Box 42

Date July 19, 1965, Driller: STANNON, MISSISSIPPI County Prentiss
(Name)

(1) Owner of Land: Lawther Cooper
(Name)

Box Baldwyn, Miss.
(Address)

(2) Location: 1/4, 1/4, Sec. 4 6 36 E

2 miles N., of Baldwyn
(distance) (direction) (Nearest Town)

(3) Topography: Hilly
(Hilly) (Flat) (Level)

(4) Purpose of Well: Domestic
(Domestic Irrigation, Municipal, Industrial, Other)

Description & Color of Materials Sand, Clay, Red Clay, Shell, etc.	Thick- ness Feet	Depth Feet
<u>Surface sand</u>		
<u>+ clay</u>		<u>0-30</u>
<u>Red clay</u>		<u>30-139</u>
<u>rock (shell)</u>		<u>139-140</u>
<u>sand</u>		<u>140-264</u>
<u>bottom</u>		<u>264</u>

Information upon completion of well:

(1) Diameter 4 inches.

(2) Total Depth 264 feet.

(3) Water Level 80 feet below top of ground.

(4) Cased to 35 1/2", Size 4"


(5) Screen: Size —, Length —

(6) Were any formations sealed against pollution?
1 yes, — no.

If YES depth of formation 30

Why surface & sand

Drillers Remarks:

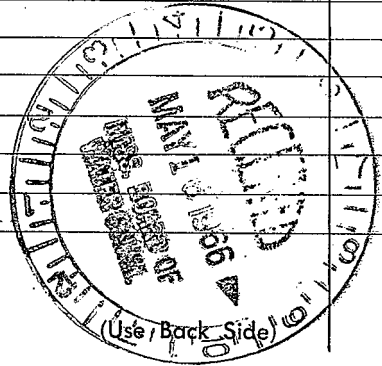

Well No.

10/10/10

10/10/10

