

PRENTISS MISSISSIPPI BOARD OF WATER COMMISSIONERS

J 2012
8-12-65

WATER WELL DRILLERS LOG

Date: Aug 12, 1965, Driller: Herndon-Homan Well & Supply, Inc. County: Prentiss
P. O. Box 42
SHANNON, MISSISSIPPI 38868

(1) Owner of Land:	Description & Color of Materials	Thick-ness Feet	Depth Feet
<u>N. Miss. Auto Auction</u> (Name) <u>Baldwin, Miss.</u> (Address)	<u>uniform sand & clay</u>	<u>0 - 10</u>	<u>10</u>
(2) Location: <u>1/4, 1/4, Sec. 23 T. 6^N R. 6^E</u>	<u>white sand & clay</u>	<u>10 - 18</u>	<u>18</u>
<u>1</u> miles <u>N.</u> , of <u>Baldwin</u> (distance) (direction) (Nearest Town)	<u>blue clay</u>	<u>18 - 56</u>	<u>56</u>
(3) Topography: <u>Flat</u> (Hilly) (Flat) (Level)	<u>hard rock</u>	<u>56 - 57</u>	<u>57</u>
(4) Purpose of Well: <u>CAR WASH</u> (Domestic Irrigation, Municipal, Industrial, Other)	<u>blue clay</u>	<u>57 - 129</u>	<u>129</u>
	<u>hard rock</u>	<u>129 - 130</u>	<u>130</u>
	<u>blue clay</u>	<u>130 - 248</u>	<u>248</u>
	<u>rock</u>	<u>248 - 249</u>	<u>249</u>
	<u>blue clay</u>	<u>249 - 288</u>	<u>288</u>
	<u>sand</u>	<u>288 - 440</u>	<u>440</u>
	<u>Bottom</u>	<u>440</u>	



Information upon completion of well:

- (1) Diameter 5 inches.
- (2) Total Depth 440 feet.
- (3) Water Level 40' feet below top of ground.
- (4) Cased to 214', Size 2"
- (5) Screen: Size 2", Length 40'
- (6) Were any formations sealed against pollution?
 yes, no.

If YES depth of formation _____

Why uniform & sand

Drillers Remarks: _____

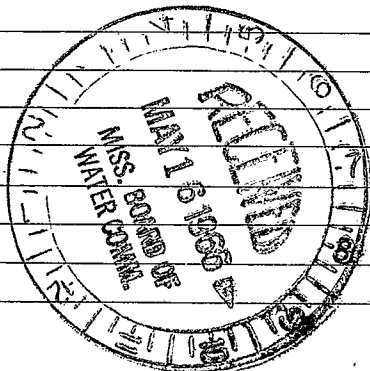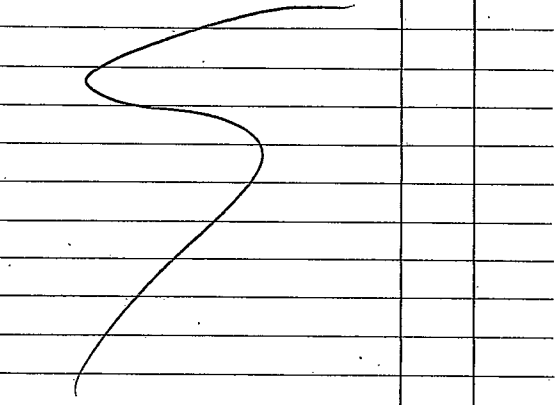

(Use Back Side)

Well No. _____

1870

1870

