

J 2013  
11-13-65

WATER WELL DRILLERS LOG

Herndon-Homan Well & Supply, Inc.

P. O. Box 42

Date: Nov 13, 1965, Driller: SHANNON, MISSISSIPPI 38650 *Prentiss*

(Name)

- (1) Owner of Land: Mr. Earl Cate  
(Name)  
St. Andrews, Miss.  
(Address)
- (2) Location: 1/4, 1/4, Sec. 11, T. 13 N. R. 16 W.  
3 miles W of Wheeler  
(distance) (direction) (Nearest Town)
- (3) Topography: Flat  
(Hilly) (Flat) (Level)
- (4) Purpose of Well: Domestic  
(Domestic Irrigation  
Municipal, Industrial, Other)

Description & Color of Materials Sand, Clay, Red Clay, Shell, etc.	Thick- ness Feet	Depth Feet
<u>sand &amp; clay</u>	<u>0-18</u>	
<u>blue clay</u>	<u>18-98</u>	
<u>sand</u>	<u>98-200</u>	
<u>bottom</u>	<u>210</u>	


Information upon completion of well:

- (1) Diameter 4 inches.
- (2) Total Depth 210 feet.
- (3) Water Level 50 feet below top of ground.
- (4) Cased to 20', Size 4"
- (5) Screen: Size     , Length
- (6) Were any formations sealed against pollution?  
 yes,  no.

If YES depth of formation 18

Why surface & ground

Drillers Remarks:     

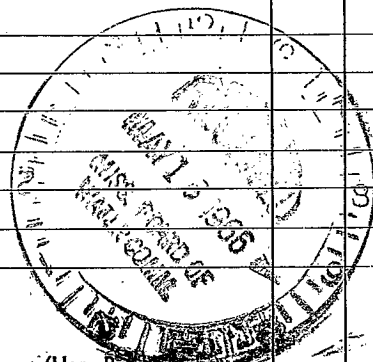

Well No.

(Use Back)

1912

1913

1914

1915

1916

1917

1918

1919

1920