

*Prentiss*  
 J2015  
 11-67

MISSISSIPPI  
 BOARD OF WATER COMMISSIONERS  
 416 North State Street  
 Jackson, Mississippi 39201

WATER WELL DRILLERS LOG

*Nov 1* 19*67* *Bond & H. Dillingham* *Prentiss*  
 date well completed firm name county well located


LANDOWNER: *Otha Bishop*  
*Rt 3*  
*Baldwyn, Miss.*  
 (mailing address)

description of formations encountered	from	to
<i>Reddy Clay</i>	<i>0'</i>	<i>19'</i>
<i>Blue Clay</i>	<i>19'</i>	<i>340'</i>
<i>Water Str.</i>	<i>340'</i>	<i>400'</i>

WELL LOCATION:  
 sec. *8* T. *6* N. R. *6* E.  
*3 1/2* miles *W*  
 (distance) (direction) (nearest town)  
*Franktown*

WELL PURPOSE: *Home*  
 (home, irrigation, municipal, industrial)

- WELL COMPLETION DATA:
- (1) diameter (inches) *4"*
  - (2) total depth (feet) *450'*
  - (3) static water level (feet) *160'* below top of ground.
  - (4) casing (material) *Bk Steel*, (depth) *21'*  
*4"* (size) if telescope see back.
  - (5) screen *none* (length), (depth to top)  
*none* (size), (material)
  - (6) pump *2* (NP), (yield gpm) *4*  
*Elect Jet* (type power)
  - (7) electric log *none* (yes or no)  
*none* (organization running log)
  - (8) how well bottom plugged *Open*

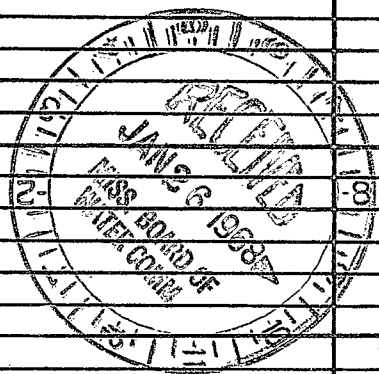

DRILLERS REMARKS:

