

Prentiss
 J2017
 5-26-68

MISSISSIPPI
 BOARD OF WATER COMMISSIONERS
 416 North State Street
 Jackson, Mississippi 39201

WATER WELL DRILLERS LOG

May 24 1968 Bonds Well Drill Prentiss
 date well completed firm name county well located


LANDOWNER: Parson Hatfield
Baldwyn Miss
 (mailing address)

description of formations encountered	from	to
Sandy loam	0	3
" grey clay	3	13
Sand & blue clay	13	40
water sand	40	104
	104	160

WELL LOCATION:
 sec. 2 T. 1 N. R. 6 E.
1 miles NW of Frankston
 (distance) (direction) (nearest town)

WELL PURPOSE: Home
 (home, irrigation, municipal, industrial)


- WELL COMPLETION DATA:
- (1) diameter (inches) 4 1/2
 - (2) total depth (feet) 160
 - (3) static water level (feet) 40 below top of ground.
 - (4) casing Steel, 4 1/2 (material) (depth)
~~4 1/2~~ If telescope see back. (size)
 - (5) screen none (length) (depth to top)
none (size) (material)
 - (6) pump Instalco Pump (HP) (yield gpm)
Pump (type power)
 - (7) electric log No (yes or no)
none (organization running log)
 - (8) how well bottom plugged Open

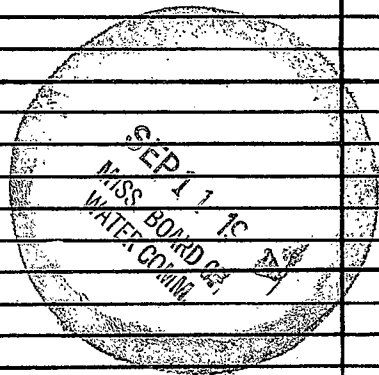

DRILLERS REMARKS:

If well telescopes please sketch and show depths.

GROUND LEVEL

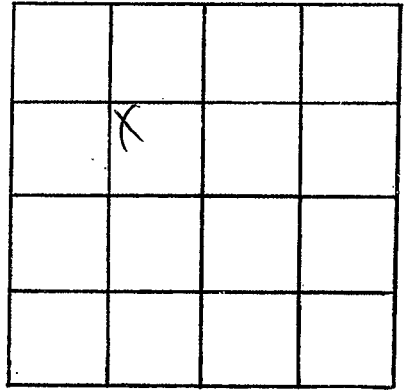

SECTION 2

Please indicate well location X.

ADDITIONAL INFORMATION

If more than one screen,
show locations of each on sketch.