

PRETISS WATER WELL DRILLERS LOG

Date: ^K Feb 10, 1962, Driller: Bonds P & D Co., County: Prentiss
 2-10-62 (Name)


(1) Owner of Land:	Description & Color of Materials Sand, Clay, Red Clay, Shell, etc.	Thick- ness Feet	Depth Feet
<i>Willie Moore</i> <small>(Name)</small>	<i>22 ft Blue</i>	<i>22</i>	
<i>Wheeler, Miss</i> <small>(Address)</small>	<i>14 ft Blue Water Sand</i>	<i>58 24</i>	
(2) Location: $\frac{1}{4}$, $\frac{1}{4}$, Sec. T R			
<i>4</i> miles <i>north E.</i> of <i>Wheeler</i> <small>(distance) (direction) (Nearest Town)</small>			
(3) Topography: <i>flat</i> <small>(Hilly) (Flat) (Level)</small>			
(4) Purpose of Well: <i>Domestic</i> <small>(Domestic Irrigation Municipal, Industrial, Other)</small>			

Information upon completion of well:

- (1) Diameter *4* inches.
- (2) Total Depth *104* feet.
- (3) Water Level *18* feet below top of ground.
- (4) Cased to *23*, Size *4"*
- (5) Screen: Size _____, Length _____.
- (6) Were any formations sealed against pollution?
 _____ yes, *yes* no.

If YES depth of formation *58 ft to blue*
 Why *Cased to blue*

Drillers Remarks: *water
Sand 24 ft.*

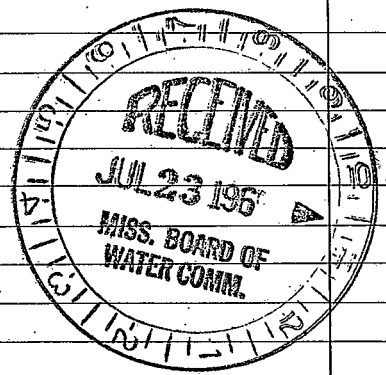

(Use Back Side)

Well No.

[Faint, illegible handwritten text, possibly bleed-through from the reverse side of the page.]