

PRENTISS
K 41
6-17-77

MISSISSIPPI
BOARD OF WATER COMMISSIONERS
416 North State Street
Jackson, Mississippi 39201

CODED

WATER WELL DRILLERS LOG

Herndon-Homan Well & Supply, Inc.

Prentiss

6-17 1977 date well completed
P. O. Box 42
SHANNON, MISSISSIPPI 38660 county well located

LANDOWNER: R. V. Ryan
Baldwyn, Miss.
(mailing address)
WELL LOCATION:
sec 33 T 6 N R 7 E
S
3 miles E of Baldwyn
(distance) (direction) (nearest town)

description of formations encountered	from	to
<u>surface sand & blue</u>	<u>0</u>	<u>95</u>
<u>Black clay</u>	<u>95</u>	<u>260</u>
<u>Sand</u>	<u>260</u>	<u>400</u>
<u>Bottom</u>	<u>400</u>	

WELL PURPOSE: Drone
(home, irrigation, municipal, industrial)

- WELL COMPLETION DATA:
- (1) diameter (inches) 5"
 - (2) total depth (feet) 400'
 - (3) static water level (feet) 140 below top of ground.
 - (4) casing Steel 101'6"
(material) (depth)
5' if telescope see back.
(size)
 - (5) screen 70 5
(length) (depth to top)
(size) (material)
 - (6) pump 1/2 5
(HP) (yield gpm)
Electric
(type power)
 - (7) electric log no
(yes or no)
 - (organization running log)
 - (8) how well bottom plugged open

CODED


1111 12 1977

MISS. BD. OF
WATER COMMISSIONERS

DRILLERS REMARKS:

If well telescopes please sketch and show depths.

GROUND LEVEL

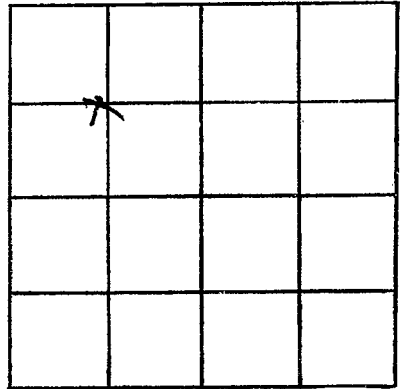

SECTION 33

Please indicate well location X.

ADDITIONAL INFORMATION

If more than one screen, show locations of each on sketch.