

Prentiss
 K-42
 7-7-71

MISSISSIPPI
 BOARD OF WATER COMMISSIONERS
 416 North State Street
 Jackson, Mississippi 39201

CODED

WATER WELL DRILLERS LOG

7-7 1971 Bondi Well Drilling Prentiss
 date well completed firm name county well located

LANDOWNER:	description of formations encountered	from	to
John Shank	Red Clay	0	37
Brownie Miss (mailing address)	Blue Clay	37	230
	Water sand	230	275

WELL LOCATION:
 sec. 17 T 6 N R 7 E
 1 1/2 miles South of Wacker
 (distance) (direction) (nearest town)

WELL PURPOSE: Home
 (home, irrigation, municipal, industrial)

WELL COMPLETION DATA:

(1) diameter (inches) 4

(2) total depth (feet) 275

(3) static water level (feet) 18 below above top of ground.

(4) casing Steel 42
 (material) (depth)
 (size) if telescope see back.

(5) screen none
 (length) (depth to top)
 (size) (material)

(6) pump Had on pump
 (HP) (yield gpm)
 (type power)

(7) electric log no
 (yes or no)
 (organization running log)

(8) how well bottom plugged open

CODED


AUG 11 1971

DRILLERS REMARKS:

MISS. BD. OF
 WATER COM.

If well telescopes please sketch and show depths.

GROUND LEVEL

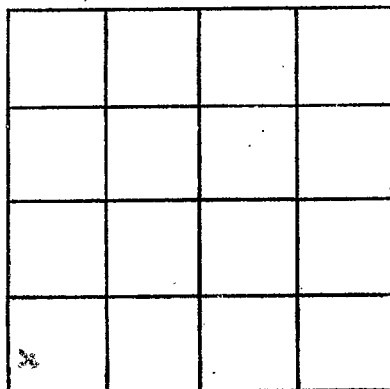

SECTION _____

Please indicate well location X.

ADDITIONAL INFORMATION

If more than one screen, show locations of each on sketch.