

Prentiss
K 42, 43
8-28-71

MISSISSIPPI
BOARD OF WATER COMMISSIONERS
416 North State Street
Jackson, Mississippi 39201

WATER WELL DRILLERS LOG

CODED

8-28-1971 date well completed Bonded Well Drilling Prentiss firm name county well located

LANDOWNER: Nellie Prather
Baldwyn Miss
(mailing address)

description of formations encountered	from	to
Red clay	0	19
Blue clay	19	208
Water sand	208	250

WELL LOCATION:
sec. 27 T. 6 N R. 7 E
4 miles East of Baldwyn
(distance) (direction) (nearest town)

WELL PURPOSE: Home
(home, irrigation, municipal, industrial)

- WELL COMPLETION DATA:
- (1) diameter (inches) 4
 - (2) total depth (feet) 250
 - (3) static water level (feet) 80 below above top of ground.
 - (4) casing Steel, 21,
(material) (depth)
(size) if telescope see back.
 - (5) screen none
(length) (depth to top)
(size) (material)
 - (6) pump 1 1/2 5
(HP) (yield gpm)
air pump
(type power)
 - (7) electric log no
(yes or no)
(organization running log)
 - (8) how well bottom plugged Open

CODED


OCT 4 - 1971

DRILLERS REMARKS:

MISS. Bd. OF
WATER COMM.

If well telescopes please sketch and show depths.

GROUND LEVEL

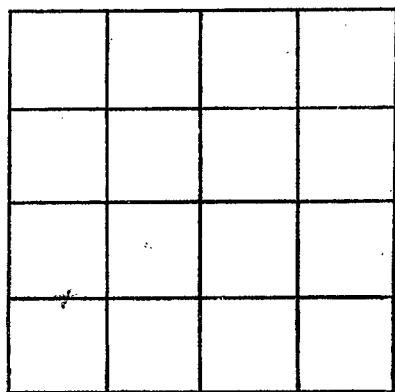

SECTION _____

Please indicate well location X.

ADDITIONAL INFORMATION

A series of horizontal lines for providing additional information, starting below the 'ADDITIONAL INFORMATION' header and extending to the bottom of the page.

If more than one screen, show locations of each on sketch.