

PRENTISS

K 45

2-28-72

MISSISSIPPI BOARD OF WATER COMMISSIONERS  
416 North State Street  
Jackson, Mississippi 39201

**CODED**

WATER WELL DRILLERS LOG

2-28

1972

Bonch Well Drilling

Prentiss

date well completed

firm name

county well located

LANDOWNER:

William Cagle

description of formations encountered

from

to

Baldwyn Miss  
(mailing address)

Red clay  
Blue clay  
Water sand

0 49  
49 291  
291 344

WELL LOCATION:

sec 32 T 6 N R 7 E

2 miles East of Baldwyn  
(distance) (direction) (nearest town)

WELL PURPOSE:

Home  
(home, irrigation, municipal, industrial)

WELL COMPLETION DATA:

- (1) diameter (inches) 4
- (2) total depth (feet) 344
- (3) static water level (feet) 81 below top of ground.

- (4) casing Steel 54  
(material) (depth)

0 if telescope see back.  
(size)

- (5) screen none  
(length) (depth to top)

(size) (material)

- (6) pump 1/2 5  
(HP) (yield gpm)

Electric pump  
(type power)

- (7) electric log no  
(yes or no)

(organization running log)


- (8) how well bottom plugged Open

DRILLERS REMARKS:

**CODED**

If well telescopes please sketch and show depths.

GROUND LEVEL

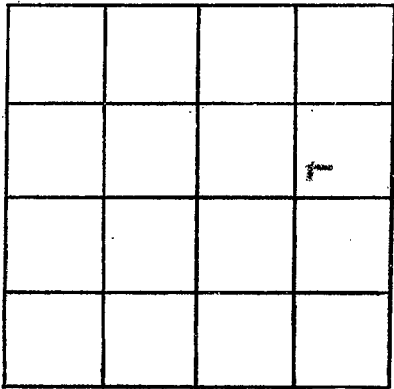

SECTION \_\_\_\_\_

Please indicate well location X.

ADDITIONAL INFORMATION

Lined area for additional information, consisting of 18 horizontal lines.

If more than one screen, show locations of each on sketch.