

13B

Prentiss
K50
9-6-68

MISSISSIPPI
BOARD OF WATER COMMISSIONERS
416 North State Street
Jackson, Mississippi 39201

CODED

WATER WELL DRILLERS LOG

68 Henden-Homan Well & Supply, Inc.
P. O. Box 42

Prentiss

9-6 19
date well completed

SHANNON, MISSISSIPPI 38860 county well located

LANDOWNER:	description of formations encountered	from	to
Edward Joznev Baldwyn, Miss (mailing address)			
WELL LOCATION:			
sec. 29 T. 20N. R. 7E 3 1/2 miles NE of Baldwyn (distance) (direction) (nearest town)			
WELL PURPOSE: Home (home, irrigation, municipal, industrial)			
WELL COMPLETION DATA:			
(1) diameter (inches) 5"			
(2) total depth (feet) 380'			
(3) static water level (feet) 137' below top of ground.			
(4) casing steel, 111' 5" (material), (depth)			
5 (size) if telescope see back.			
(5) screen NO (length), (depth to top)			
(size) (material)			
(6) pump 1/2 (HP), 5 (yield gpm) electric (type power)			
(7) electric log NO (yes or no)			
(organization running log)	OCT 16 1968		
(8) how well bottom plugged open			


CODED

DRILLERS REMARKS:

MISS. BD. OF
WATER COMM.

If well telescopes please sketch and show depths.

GROUND LEVEL

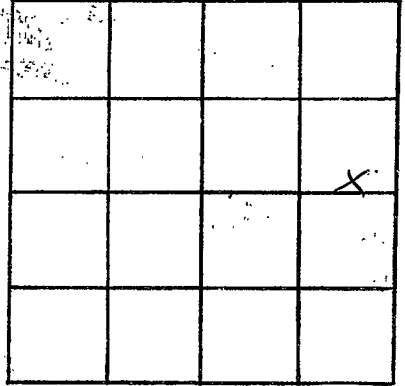

SECTION 29

Please indicate well location X.

ADDITIONAL INFORMATION

If more than one screen,
show locations of each on sketch.