

Returned 2/21/69

OKGR CODED

PRENTISS  
 K 51  
 12-12-68  
 12-12-68 19  
 date well completed

MISSISSIPPI  
 BOARD OF WATER COMMISSIONERS  
 416 North State Street  
 Jackson, Mississippi 39201

WATER WELL DRILLERS LOG

Wingless & Drilling Co. Prentiss  
 firm name county well located

LANDOWNER:  
 G. Stanley Hanson  
 Rt 2 Baulhusin  
 (mailing address)

description of formations encountered	from	to
Joint Clay & Red Sand	0	50
Blue	30	70
mix Sand & Blue	70	285
Hard Rock	196	197
Sand	285	413

WELL LOCATION:  
 sec 30 T 6 N R 7 E  
 3 miles 3 1/2 of Wheeler  
 (distance) (direction) (nearest town)

WELL PURPOSE: home  
 (home, irrigation, municipal, industrial)

- WELL COMPLETION DATA:
- (1) diameter (inches) 4
  - (2) total depth (feet) 413
  - (3) static water level (feet) 60 below top of ground
  - (4) casing CT 63' (material) (depth)  
 if telescope see back. (size)
  - (5) screen 33' (length) (depth to top)  
 (size) (material)
  - (6) pump 3/4 HP 680 (yield gpm)  
 EP 220 (type power)
  - (7) electric log (yes or no)  
 (organization running log)
  - (8) how well bottom plugged

CODED


FEB 13 1969

MISS. Bd. OF WATER SUPPLY

DRILLERS REMARKS:

If well telescopes please sketch and show depths.

GROUND LEVEL

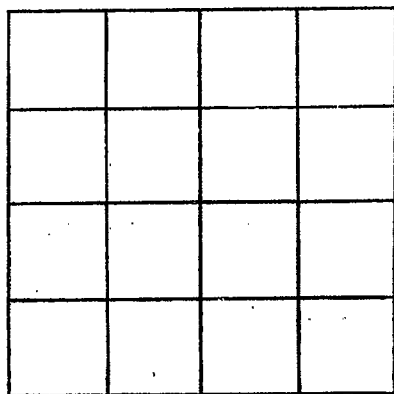

SECTION \_\_\_\_\_

Please indicate well location X.

ADDITIONAL INFORMATION

If more than one screen, show locations of each on sketch.