

CODED

MISSISSIPPI
BOARD OF WATER COMMISSIONERS
416 North State Street
Jackson, Mississippi 39201

WATER WELL DRILLERS LOG

Prentiss
152
3-22-69

March 22 19 69 J. W. Welch & son Prentiss
date well completed firm name county well located

LANDOWNER:

R. E. Shaw

description of formations encountered

from

to

Baldwin, Miss
(mailing address)

<u>Clay</u>	<u>0</u>	<u>2.0</u>
<u>sand & clay</u>	<u>20</u>	<u>45</u>
<u>Blue mud</u>	<u>45</u>	<u>120</u>
<u>Water sand & Blue mud</u>	<u>120</u>	<u>160</u>
<u>Water sand</u>	<u>160</u>	<u>280</u>

WELL LOCATION:

Sec 11 T69 N R 7 E
5 miles West of Moreau
(distance) (direction) (nearest town)

WELL PURPOSE: home
(home, irrigation, municipal, industrial)

WELL COMPLETION DATA:

- (1) diameter (inches) 5"
- (2) total depth (feet) 280
- (3) static water level (feet) 100 ~~below~~ above top of ground.
- (4) casing Steel 63'
(material) (depth)
 if telescope see back.
(size)
- (5) screen none
(length) (depth to top)

(size) (material)
- (6) pump 1/2 10
(HP) (yield gpm)
electric
(type power)
- (7) electric log no
(yes or no)
- (organization running log)
- (8) how well bottom plugged

CODED

CODED


APR 1 1969

DRILLERS REMARKS:

MISS. BD. OF
WATER COMMISSIONERS

If well telescopes please sketch and show depths.

GROUND LEVEL

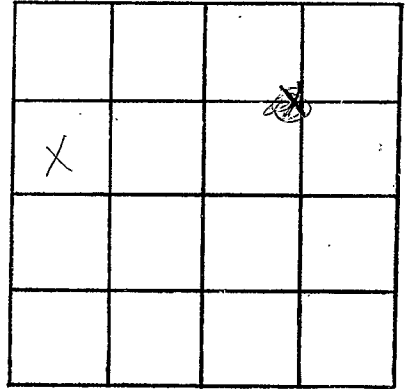

SECTION

~~36~~ 36

Please indicate well location X.

ADDITIONAL INFORMATION

If more than one screen,
show locations of each on sketch.