

CODED

MISSISSIPPI
BOARD OF WATER COMMISSIONERS
416 North State Street
Jackson, Mississippi 39201

WATER WELL DRILLERS LOG

Prentiss
K 53
6-11-69

6-11 date well completed 19*69* *Bondwell Drilling* firm name *Prentiss* county well located

LANDOWNER: *James H. Brown*
R. 2
Baldwin
(mailing address)

description of formations encountered	from	to
<i>Red sand</i>	<i>0</i>	<i>78</i>
<i>Blue clay</i>	<i>78</i>	<i>130</i>
<i>Water sand</i>	<i>130</i>	<i>130</i>

WELL LOCATION:
sec. *17* T-*6* N R-*7* E
2 1/2 miles *S* miles *South East* of *Walden*
(distance) (direction) (nearest town)

WELL PURPOSE: *Home*
(home, irrigation, municipal, industrial)


- WELL COMPLETION DATA:
- (1) diameter (inches) *4*
 - (2) total depth (feet) *260*
 - (3) static water level (feet) _____ below above top of ground.
 - (4) casing *Steel* (material), *84* (depth)
_____ (size) if telescope see back.
 - (5) screen *None* (length) _____ (depth to top)
_____ (size) _____ (material)
 - (6) pump *Jet* (HP) _____ (yield gpm)
_____ (type power)
 - (7) electric log *No* (yes or no)
_____ (organization running log)
 - (8) how well bottom plugged *Open*

DRILLERS REMARKS:

7-7-69
MISSISSIPPI
BOARD OF WATER COMMISSIONERS

If well telescopes please sketch and show depths.

GROUND LEVEL

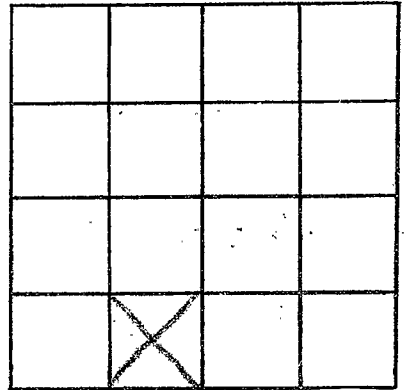

SECTION 17

Please indicate well location X.

ADDITIONAL INFORMATION

If more than one screen,
show locations of each on sketch.