

Prentiss Co.
K 55
7-69

MISSISSIPPI
BOARD OF WATER COMMISSIONERS
416 North State Street
Jackson, Mississippi 39201

WATER WELL DRILLERS LOG


7-2 1969 Bomb Well City Prentiss
date well completed firm name county well located

LANDOWNER: <u>Henry Regan</u>	description of formations encountered	from	to
<u>R. 2</u>	<u>mix sand</u>	<u>0</u>	<u>118</u>
<u>Baldwin</u> (mailing address)	<u>blue clay</u>	<u>118</u>	<u>230</u>
WELL LOCATION:	<u>water sand</u>	<u>230</u>	<u>290</u>
sec. <u>29</u> T. <u>6</u> N. R. <u>7</u> E <u>4</u> miles <u>NE</u> of <u>Baldwin</u> (distance) (direction) (nearest town)			
WELL PURPOSE: <u>Home</u> (home, irrigation, municipal, industrial)			
WELL COMPLETION DATA:			
(1) diameter (inches) <u>4</u>			
(2) total depth (feet) <u>290</u>			
(3) static water level (feet) <u>105</u> below top of ground.			
(4) casing <u>Steel</u> , <u>126</u> (material) (depth)			
(size) if telescope see back.			
(5) screen <u>none</u> (length) (depth to top)			
(size) (material)			
(6) pump <u>1 1/2</u> <u>5</u> (HP) (yield gpm)			
<u>Electric</u> (type power)			
(7) electric log <u>no</u> (yes or no)			
(organization running log)			
(8) how well bottom plugged <u>Open</u>			
DRILLERS REMARKS:			

APR 17 1969
MISS. Bd. OF WATER COM.

If well telescopes please sketch and show depths.

GROUND LEVEL

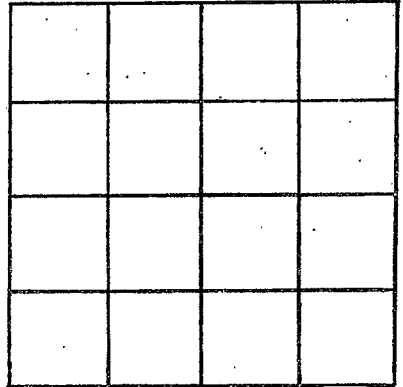

SECTION _____

Please indicate well location X.

ADDITIONAL INFORMATION

If more than one screen,
show locations of each on sketch.