

Prentiss Co
K 56
11-69

MISSISSIPPI
BOARD OF WATER COMMISSIONERS
416 North State Street
Jackson, Mississippi 39201

CODED

WATER WELL DRILLERS LOG

11-20-69
date well completed

19 Glendon Thomas Well & Supply
firm name

Prentiss
county well located

LANDOWNER: J. Mac Hudson
(A.C. Nick)

description of formations encountered	from	to
Surface sand & clay	0	28
Black clay	28	35
Sand	35	140
Bottom	140	

(mailing address)

WELL LOCATION:

sec 20 T 6 N S R 7 E
2 1/2 miles NW of Marietta
(distance) (direction) (nearest town)

WELL PURPOSE:
(home, irrigation, municipal, industrial)

WELL COMPLETION DATA:

- (1) diameter (inches) 5"
- (2) total depth (feet) 140'
- (3) static water level (feet) 60 below top of ground
- (4) casing Steel 31'
(material) (depth)
5" if telescope see back.
(size)
- (5) screen _____
(length) (depth to top)
(size) (material)
- (6) pump _____
(HP) (yield gpm)
(type power)
- (7) electric log _____
(yes or no)
(organization running log)
- (8) how well bottom plugged _____


DEC 11 1969

DRILLERS REMARKS:

MISS. BD. OF
WATER COMM.

If well telescopes please sketch and show depths.

GROUND LEVEL

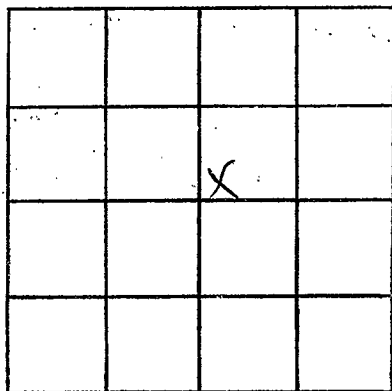

SECTION 20

Please indicate well location X.

ADDITIONAL INFORMATION

If more than one screen, show locations of each on sketch.