

Prentiss

K 58

4-6-70

MISSISSIPPI  
 BOARD OF WATER COMMISSIONERS  
 416 North State Street  
 Jackson, Mississippi 39201

WATER WELL DRILLERS LOG

4-12

1970 Bondwell Drilling

Prentiss

days well completed

firm name

county well located

LANDOWNER: Billy Brown

description of formations encountered

from

to

Brownville

(mailing address)

Yellow sand 0 18  
red. blue 18 118  
black clay 118 200  
water sand 200 260

WELL LOCATION:

sec. 33 T. 6 N. R. 7

8 miles East of Baldwyn  
(distance) (direction) (nearest town)

WELL PURPOSE:

(home, irrigation, municipal, industrial) Home

WELL COMPLETION DATA:

- (1) diameter (inches) 4
- (2) total depth (feet) 260
- (3) static water level (feet) 105 below above top of ground.

(4) casing Steel 126  
(material) (depth)

         if telescope see back.  
(size)

(5) screen none  
(length) (depth to top)

         (size) (material)

(6) pump          (HP)          (yield gpm)  
Hand on pump  
(type power)

(7) electric log no  
(yes or no)

          
(organization running log)

(8) how well bottom plugged Open


DRILLERS REMARKS:

MAY 4 1970

MISS. BD. OF  
WATER COMM.

If well telescopes please sketch and show depths.

GROUND LEVEL

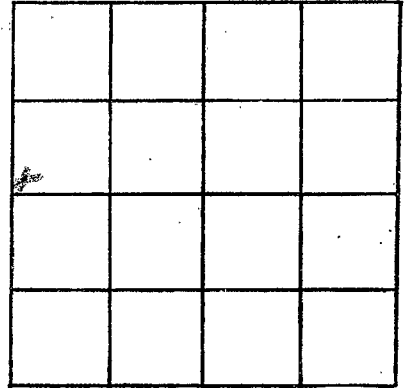

SECTION \_\_\_\_\_

Please indicate well location X.

ADDITIONAL INFORMATION

If more than one screen,  
show locations of each on sketch.