

PRENTISS

K 59

11-5-70

MISSISSIPPI BOARD OF WATER COMMISSIONERS
416 North State Street
Jackson, Mississippi 39201

CODED

WATER WELL DRILLERS LOG

11-5-70 date well completed 1970 Bond Well Drilling firm name Prentiss county well located

LANDOWNER: Charles Howell

description of formations encountered

from

to

Baldwin Miss
(mailing address)

Red sand
Blue clay
Water sand

0 37
37 243
243 300

WELL LOCATION:

sec. 32 T 6 N R 7 E
3 miles East of Baldwin
(distance) (direction) (nearest town)

WELL PURPOSE: Home
(home, irrigation, municipal, industrial)

WELL COMPLETION DATA:

CODED

- (1) diameter (inches) 4
- (2) total depth (feet) 300
- (3) static water level (feet) 60 below top of ground.
- (4) casing Steel, 42 (material) (depth)
- (size) if telescope see back.
- (5) screen None (length) (depth to top)
- (size) (material)
- (6) pump 3/4 (HP) 5 (yield gpm)
- Elect (type power)
- (7) electric log no (yes or no)
- (organization running log)
- (8) how well bottom plugged Open


DRILLERS REMARKS:

DEC 7 1970

MISS. Bd. of WATER COMMISSIONERS

If well telescopes please sketch and show depths.

GROUND LEVEL

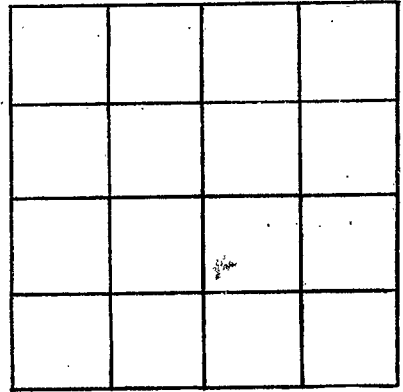

SECTION _____

Please indicate well location X.

ADDITIONAL INFORMATION

If more than one screen, show locations of each on sketch.