

PRENTISS  
K 60  
11-6-70

MISSISSIPPI  
BOARD OF WATER COMMISSIONERS  
416 North State Street  
Jackson, Mississippi 39201

**CODED**

WATER WELL DRILLERS LOG

11-6 1970 Bond Well Drilling Prentiss  
date well completed firm name county well located

LANDOWNER: Tom Moore  
Baldwin Miss  
(mailing address)

description of formations encountered	from	to
<u>Red Clay</u>	<u>0</u>	<u>15</u>
<u>Blue Clay</u>	<u>15</u>	<u>127</u>
<u>Water Sand</u>	<u>127</u>	<u>170</u>

WELL LOCATION:  
sec. 12 T. 7 N R. 7 E  
7 miles East of Baldwin  
(distance) (direction) (nearest town)

WELL PURPOSE: Home  
(home, irrigation, municipal, industrial)

- WELL COMPLETION DATA:
- (1) diameter (inches) 4
  - (2) total depth (feet) 170
  - (3) static water level (feet) 43 below top of ground.
  - (4) casing Steel 21  
(material) (depth)  
         if telescope see back.  
(size)
  - (5) screen none  
(length) (depth to top)  
         (size) (material)
  - (6) pump 3/4 5  
(HP) (yield gpm)  
Electric  
(type power)
  - (7) electric log no  
(yes or no)  
         (organization running log)
  - (8) how well bottom plugged open

**CODED**


DEC 7 1970

DRILLERS REMARKS:

MISS. BD. OF  
WATER COMMISSIONERS

If well telescopes please sketch and show depths.

GROUND LEVEL

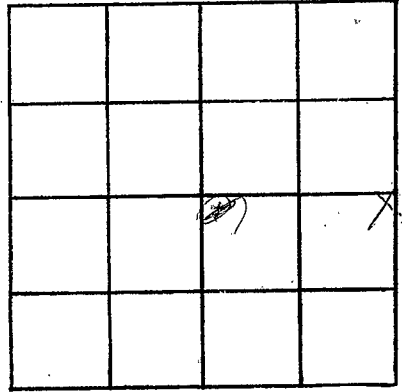

SECTION 11

Please indicate well location X.

ADDITIONAL INFORMATION

If more than one screen, show locations of each on sketch.