

PRENTISS

K67

2-14-73

MISSISSIPPI
 BOARD OF WATER COMMISSIONERS
 416 North State Street
 Jackson, Mississippi 39201

WATER WELL DRILLERS LOG

Herman Homan Well & Supply, Inc.

Prentiss

2-14-73

date well completed

firm name

SHANNON, MISSISSIPPI 38668

county well located

LANDOWNER:

description of formations encountered

from

to

Dwain Cagle
 P.O. Box 100, Booneville, Miss.
 (mailing address)

Suber sand & clay
 Blue clay
 Sand
 Bottom

0	18
18	180
180	300
300	

WELL LOCATION:

sec. 25 T. 6 N. R. 7 E.
 5 miles NE of Booneville
 (distance) (direction) (nearest town)

WELL PURPOSE:

(home, irrigation, municipal, industrial)

WELL COMPLETION DATA:

- (1) diameter (inches) 5
- (2) total depth (feet) 300
- (3) static water level (feet) 120 below top of ground.
- (4) casing steel, 21' (material) (depth)
 5" (size) if telescope see back.
- (5) screen 100 (length) (depth to top)
 (size) (material)
- (6) pump 1/2 (HP) 5 (yield gpm)
 electric (type power)
- (7) electric log 100 (yes or no)

(organization running log)

(8) how well bottom plugged open

DRILLERS REMARKS:


CODED

MISSISSIPPI BOARD OF WATER COMMISSIONERS

MIS. 100-1000

If well telescopes please sketch and show depths.

GROUND LEVEL

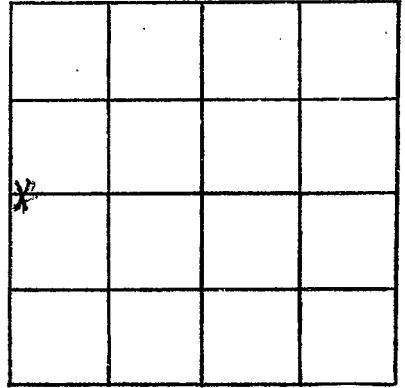

SECTION 25

Please indicate well location X.

ADDITIONAL INFORMATION

If more than one screen,
show locations of each on sketch.