

PRENTISS
K 70
4-13-73

MISSISSIPPI
BOARD OF WATER COMMISSIONERS
416 North State Street
Jackson, Mississippi 39201

CODED

WATER WELL DRILLERS LOG

4-13 1973 Bonds Well Drilling Prentiss
date well completed firm name county well located

LANDOWNER: Gray Ryan

description of formations encountered from to

Booneville, Ms.
(mailing address)

Red clay 0 58
Blue clay 38 336
Water sand 336 376

WELL LOCATION:
sec. 15 T 6 N R 7 E
9 miles South of Booneville
(distance) (direction) (nearest town)

WELL PURPOSE: Home
(home, irrigation, municipal, industrial)

WELL COMPLETION DATA:

(1) diameter (inches) 4
(2) total depth (feet) 376
(3) static water level (feet) 120 below above top of ground.
(4) casing steel, 44
(material) (depth)

CODED

 if telescope see back.
(size)
(5) screen None,
(length) (depth to top)

 (size) (material)
(6) pump 3/4, 5
(HP) (yield gpm)
Sub.
(type power)

(7) electric log NO
(yes or no)

(organization running log)


(8) how well bottom plugged open

DRILLERS REMARKS:

MISSISSIPPI BOARD OF WATER COMMISSIONERS

If well telescopes please
sketch and show depths.

GROUND LEVEL

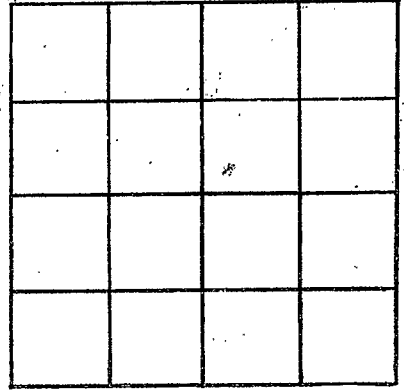

SECTION _____

Please indicate well location X.

ADDITIONAL INFORMATION

If more than one screen,
show locations of each on sketch.