

**PRENTISS**  
**LEE**  
**K 74**  
**7-23-73**

MISSISSIPPI  
 BOARD OF WATER COMMISSIONERS  
 416 North State Street  
 Jackson, Mississippi 39201

**CODED**  
 Prentiss  
 Lee

**WATER WELL DRILLERS LOG**

Herman Homan Well & Supply, Inc.

6-77 1973  
 date well completed

Box 42

county well located

SHANNON, MISSISSIPPI 38168

**LANDOWNER:**

Callen Kees  
 Rt 2 Baldwyn Miss.  
 (mailing address)

**description of formations encountered**

surface sand &  
 clay  
 blue clay  
 sand  
 bottom

from to

0 85  
 85 150  
 150 340  
 340

**WELL LOCATION:**

sec 35 T 6 S R 7 E  
 5 miles E of Baldwyn  
 (distance) (direction) (nearest town)

**WELL PURPOSE:**

(home, irrigation, municipal, industrial)  
 Home

**WELL COMPLETION DATA:**

- (1) diameter (inches) 5"
- (2) total depth (feet) 340'
- (3) static water level (feet) 106' below top of ground.
- (4) casing steel, 98 1/2" (material) (depth)  
 5 (size) if telescope see back.
- (5) screen ND (length) (depth to top)  
 (size) (material)
- (6) pump 1/2 (HP) 5 (yield gpm)  
 electric (type power)
- (7) electric log ND (yes or no)  
 (organization running log)
- (8) how well bottom plugged ND


**CODED**

**DRILLERS REMARKS:**

JUL 18 1973

If well telescopes please sketch and show depths.

GROUND LEVEL

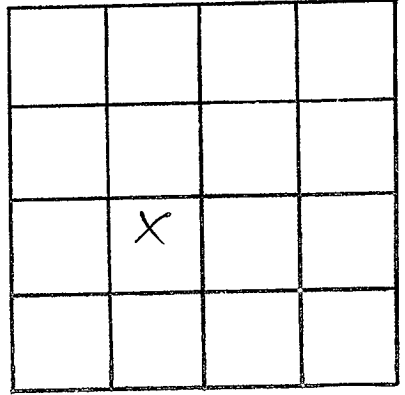

SECTION 32

Please indicate well location X.

ADDITIONAL INFORMATION

If more than one screen, show locations of each on sketch.