

PRENTISS

K 75

7-23-73

MISSISSIPPI
 BOARD OF WATER COMMISSIONERS
 416 North State Street
 Jackson, Mississippi 39201

CODED

WATER WELL DRILLERS LOG

Herman Homan Well & Supply, Inc.

Prentiss

6-28 1973 date well completed

P.O. Box 42

SHANNON, MISSISSIPPI 38668

county well located

LANDOWNER:

Cecil Short

description of formations encountered

Duffee sand & clay

from

to

PO 2 Baldwyn Miss (mailing address)

Baldwyn clay sand water

0 85
85 180
180 320
320

WELL LOCATION:

sec. 35 T 6 N R 7 E S miles E of Baldwyn (distance) (direction) (nearest town)

WELL PURPOSE: Home (home, irrigation, municipal, industrial)

WELL COMPLETION DATA:

- (1) diameter (inches) 5"
- (2) total depth (feet) 320'
- (3) static water level (feet) 105' below top of ground.
- (4) casing steel 93'7" (material) (depth)
5" (size) if telescope see back.
- (5) screen NO (length) (depth to top)
(size) (material)
- (6) pump 1/2 (HP) 5 (yield gpm)
electric (type power)
- (7) electric log NO (yes or no)
(organization running log)
- (8) how well bottom plugged open


CODED

JUL 18 1973

DRILLERS REMARKS:

If well telescopes please sketch and show depths.

GROUND LEVEL

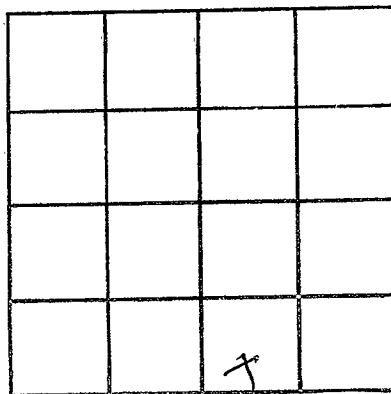

SECTION 35

Please indicate well location X.

ADDITIONAL INFORMATION

If more than one screen, show locations of each on sketch.