

PRENTISS  
K76  
8-10-73

MISSISSIPPI  
BOARD OF WATER COMMISSIONERS  
416 North State Street  
Jackson, Mississippi 39201

OCT 19 1973  
CODED  
MISS. BD. OF  
WATER COMM.

WATER WELL DRILLERS LOG

8-10 1973 Bond Well Drilling Prentiss  
date well completed firm name county well located

LANDOWNER:

Robert Steven

Baldwyn, Miss  
(mailing address)

WELL LOCATION:

sec. 35 T 6 N R 7 E  
4 miles E of Baldwyn  
(distance) (direction) (nearest town)

WELL PURPOSE: Home  
(home, irrigation, municipal, industrial)

WELL COMPLETION DATA:

- (1) diameter (inches) 4
- (2) total depth (feet) 340
- (3) static water level (feet) 120 <sup>below</sup> top of ground.
- (4) casing Steel 6 1/4'  
(material) (depth)

\_\_\_\_\_ If telescope see back.  
(size)

- (5) screen None  
(length) (depth to top)

\_\_\_\_\_ (size) (material)

- (6) pump 3/4 6  
(HP) (yield gpm)

Submers  
(type power)

- (7) electric log no  
(yes or no)

\_\_\_\_\_ (organization running log)

- (8) how well bottom plugged open

description of formations encountered

from

to


<u>Red clay</u>	<u>0</u>	<u>21</u>
<u>Blue sand</u>	<u>21</u>	<u>59</u>
<u>Blue clay</u>	<u>59</u>	<u>285</u>
<u>water sand</u>	<u>285</u>	<u>340</u>

CODED

DRILLERS REMARKS:

If well telescopes please sketch and show depths.

GROUND LEVEL

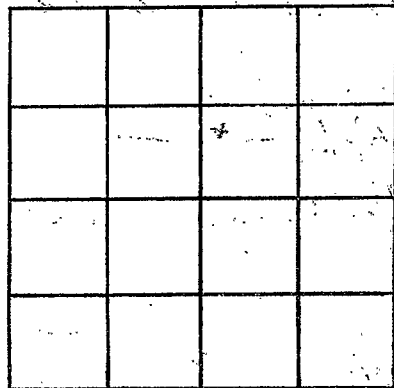

SECTION \_\_\_\_\_

Please indicate well location X.

ADDITIONAL INFORMATION

If more than one screen, show locations of each on sketch.