

PRENTISS
K 78
2-8-74

MISSISSIPPI
BOARD OF WATER COMMISSIONERS
 416 North State Street
 Jackson, Mississippi 39201

WATER WELL DRILLERS LOG CODED

date well completed 2-8-74 19 74 Herman Homan Well & Supply, Inc. Prentiss county well located
 P.O. BOX 42
 SHANNON, MISSISSIPPI 38868

LANDOWNER:
Charles Hall
Baldwyn Miss.
 (mailing address)

description of formations encountered	from	to
<u>Surface sand</u>	<u>0</u>	<u>55</u>
<u>Clay</u>	<u>55</u>	<u>180</u>
<u>Blue clay</u>	<u>180</u>	<u>320</u>
<u>Sand</u>	<u>180</u>	<u>320</u>
<u>Bottom</u>	<u>320</u>	

WELL LOCATION:
 sec. 32 T. 6 N. R. 7 E.
S W
2 miles E of Baldwyn
 (distance) (direction) (nearest town)

WELL PURPOSE: Home
 (home, irrigation, municipal, industrial)

- WELL COMPLETION DATA:
- diameter (inches) 5 1/4
 - total depth (feet) 320'
 - static water level (feet) 69' below above top of ground.
 - casing Steel 6 1/4"
 (material) (depth)
5" if telescope see back.
 (size)
 - screen NO
 (length) (depth to top)
 (size) (material)
 - pump 1/2 5
 (HP) (yield gpm)
electric
 (type power)
 - electric log NO
 (yes or no)
 (organization running log)
 - how well bottom plugged Spec


CODED

REGISTERED
MAR 14 1974

DRILLERS REMARKS:

If well telescopes please sketch and show depths.

GROUND LEVEL

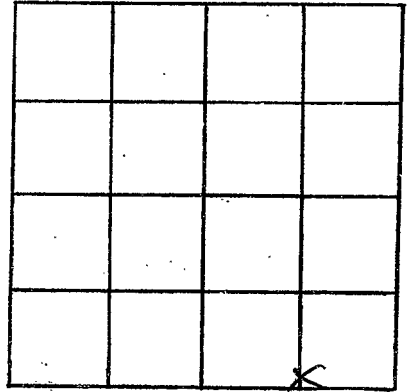

SECTION 52

Please indicate well location X.

ADDITIONAL INFORMATION

If more than one screen,
show locations of each on sketch.