

PRENTISS
K 79
4-12-74

MISSISSIPPI
BOARD OF WATER COMMISSIONERS
416 North State Street
Jackson, Mississippi 39201

CODED

WATER WELL DRILLERS LOG

Herman Homan Well & Supply, Inc.

P. O. Box 42

Prentiss

date well completed

19 74

SHANNON, MISSISSIPPI 38668

county well located

LANDOWNER:

Lester Knowles

Baldwyn, Miss.
(mailing address)

description of formations encountered

Surface sand & clay
Blue clay
Sand
Bottom

from

to

0 90
90 200
200 340
340

WELL LOCATION:

sec 26 T 6 S R 7 E
4 miles E of Baldwyn
(distance) (direction) (nearest town)

WELL PURPOSE:

(home, irrigation, municipal, industrial)

WELL COMPLETION DATA:

- (1) diameter (inches) 5"
- (2) total depth (feet) 340'
- (3) static water level (feet) 121' below top of ground.
- (4) casing steel, 1.5" (material), 1.5' (depth), 5" (size) if telescope see back.
- (5) screen ND (length), (depth to top)
- (6) pump 1/2 (HP), 5 (yield gpm), electric (type power)
- (7) electric log NO (yes or no)
- (organization running log)
- (8) how well bottom plugged open


CODED

DRILLERS REMARKS:

MAY 7 1974
MISS. Bd. of Water Comm.

If well telescopes please sketch and show depths.

GROUND LEVEL

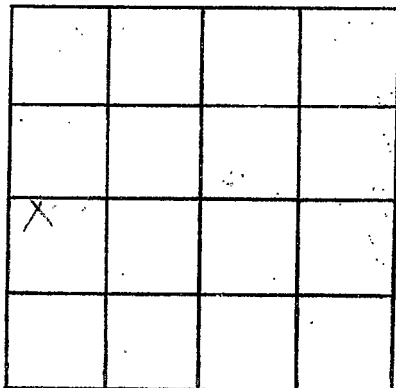

SECTION 26

Please indicate well location X.

ADDITIONAL INFORMATION

If more than one screen,
show locations of each on sketch.