

Prentiss
K82
2-13-79

MISSISSIPPI
BOARD OF WATER COMMISSIONERS
416 North State Street
Jackson, Mississippi 39201

CODED

WATER WELL DRILLERS LOG

2-13 date well completed 1974 Bonds Well Drilling firm name Prentiss county well located

LANDOWNER: Banker Hendrix
Baldwyn, Miss
(mailing address)

description of formations encountered	from	to
Red Clay	0	38
Blue Clay	38	280
Water Sand	280	320

WELL LOCATION:
sec 32 T 6 N R 7 E
1 miles East of Baldwyn
(distance) (direction) (nearest town)

CODED

WELL PURPOSE: home
(home, irrigation, municipal, industrial)


- WELL COMPLETION DATA:
- (1) diameter (inches) 4"
 - (2) total depth (feet) 320
 - (3) static water level (feet) 70 below
above
top of ground.
 - (4) casing Steel, 42,
(material) (depth)
_____ if telescope see back.
(size)
 - (5) screen _____
(length) (depth to top)
(size) (material)
 - (6) pump 1/2 5
(HP) (yield gpm)
jet
(type/power)
 - (7) electric log no
(yes or no)
(organization running log)
 - (8) how well bottom plugged open

RECEIVED
JUN 26 1974

DRILLERS REMARKS:

If well telescopes please sketch and show depths.

GROUND LEVEL

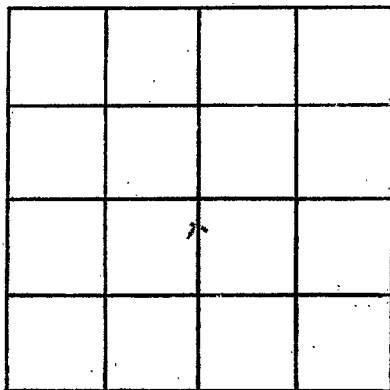

SECTION _____

Please indicate well location X.

ADDITIONAL INFORMATION

If more than one screen, show locations of each on sketch.