

Prentiss
K 83
7-2-74

MISSISSIPPI
BOARD OF WATER COMMISSIONERS
416 North State Street
Jackson, Mississippi 39201

CODED

WATER WELL DRILLERS LOG

7-2 1974 Bronsvill Drilling Prentiss
date well completed firm name county well located

LANDOWNER: B. V. Clifton
Bronsvill, Miss.
(mailing address)

description of formations encountered	from	to
Red clay	0	40
Blue sand	40	117
Blue clay	117	305
Water sand	305	365

WELL LOCATION:
sec. 11 T. 6 N R. 7 E
5 miles SE of Bronsvill
(distance) (direction) (nearest town)

WELL PURPOSE: home
(home, irrigation, municipal, industrial)


- WELL COMPLETION DATA:
- (1) diameter (inches) 4"
 - (2) total depth (feet) 365'
 - (3) static water level (feet) 140' ^{below} above top of ground.
 - (4) casing Steel, 126'
(material) (depth)
 - None if telescope see back.
(size)
 - (5) screen None
(length) (depth to top)
 - (size) (material)
 - (6) pump 3/4 10
(HP) (yield gpm)
 - Sub
(type power)
 - (7) electric log NO
(yes or no)
 - (organization running log)
 - (8) how well bottom plugged open

RECEIVED
OCT - 1 1974

DRILLERS REMARKS:

If well telescopes please sketch and show depths.

GROUND LEVEL

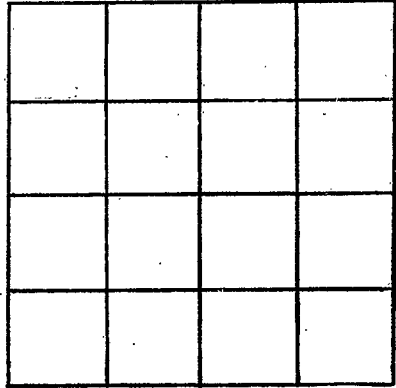

SECTION _____

Please indicate well location X.

ADDITIONAL INFORMATION

If more than one screen, show locations of each on sketch.