

Prentiss
K 84
9/16/74

MISSISSIPPI
BOARD OF WATER COMMISSIONERS
416 North State Street
Jackson, Mississippi 39201

CODED

WATER WELL DRILLERS LOG

Herman Homan Well & Supply, Inc.

Prentiss

9/16
date well completed

1974

P. O. Box 42

SHANNON, MISSISSIPPI 38868

county well located

LANDOWNER:

ESTA BARKER

description of formations encountered

from

to

Surface sand & clay	0	95
Blue clay	95	220
Sand	220	360
Bottom	360	

Rt 2 Baldwyn, Miss
(mailing address)

WELL LOCATION:

sec. 27 T 6 N R 7 E
S W
4 miles NE of Baldwyn
(distance) (direction) (nearest town)

WELL PURPOSE: Home
(home, irrigation, municipal, industrial)

WELL COMPLETION DATA:


- (1) diameter (inches) 4 1/2
- (2) total depth (feet) 360
- (3) static water level (feet) 149 below top of ground
- (4) casing steel 10.5" (material) 10' (depth)
- 4" If telescope see back. (size)
- (5) screen 20 (length) (depth to top)
- (size) (material)
- (6) pump 3/4 (HP) 12 (yield gpm)
- electric (type power)
- (7) electric log 20 (yes or no)

CODED

(organization running log)

(8) how well bottom plugged open


DRILLERS REMARKS:

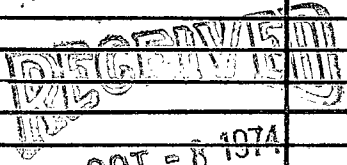

MISS. Bd. OF WATER COMMISSIONERS

If well telescopes please sketch and show depths.

GROUND LEVEL

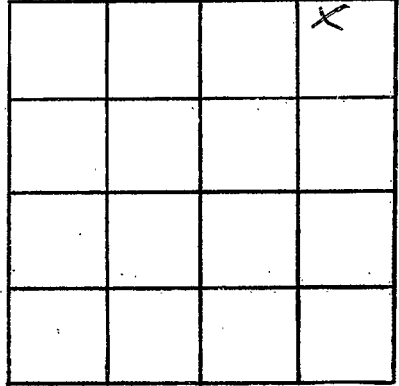

SECTION 27

Please indicate well location X.

ADDITIONAL INFORMATION

If more than one screen, show locations of each on sketch.