

Prentiss
K85
9/16/74

MISSISSIPPI
BOARD OF WATER COMMISSIONERS
416 North State Street
Jackson, Mississippi 39201

WATER WELL DRILLERS LOG

9/16 1974 Herman Homan Well & Supply, Inc.
date well completed P.O. Box 42
SHANNON, MISSISSIPPI 38868 Prentiss county well located

LANDOWNER:
Bob Colar
Baldwyn, Miss.
(mailing address)

description of formations encountered	from	to
Surface sand clay	0	55
Blue clay	55	200
Sand	200	340
Bottom	340	

WELL LOCATION:
sec. 32 T 6 N R 7 E
S E
1-3/4 miles E of Baldwyn
(distance) (direction) (nearest town)

WELL PURPOSE: Home
(home, irrigation, municipal, industrial)

- WELL COMPLETION DATA:
- diameter (inches) 4"
 - total depth (feet) 340'
 - static water level (feet) 69' below top of ground.
 - casing steel, 63' (material) (depth)
4" (size) if telescope see back.
 - screen no (length) (depth to top)
(size) (material)
 - pump 1 (HP) 5 (yield gpm)
electr (type power)
 - electric log no (yes or no)
(organization running log)
 - how well bottom plugged by se

DRILLERS REMARKS:


CODED

REGISTERED
K85
115

OCT - 8 1974

If well telescopes please sketch and show depths.

GROUND LEVEL

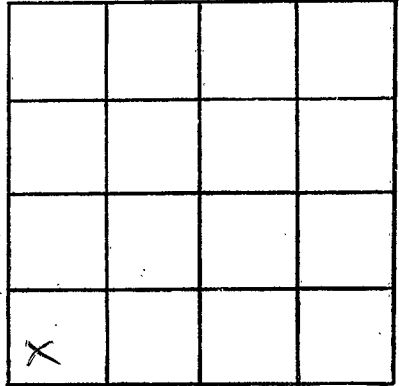

SECTION 32

Please indicate well location X.

ADDITIONAL INFORMATION

If more than one screen, show locations of each on sketch.