

PRENTISS
K86
2-26-75
Elog #67

MISSISSIPPI
BOARD OF WATER COMMISSIONERS
416 North State Street
Jackson, Mississippi 39201

WATER WELL DRILLERS LOG CODED

Feb. 26 19 75 Herndon Well & Supply, Inc. Prentiss
date well completed firm name county well located

LANDOWNER: Wheeler-
Frankstown Water Assoc., Inc.
Wheeler, MS
(mailing address)

WELL LOCATION:
sec. 7 T 6 S R 7 E 13B
Inside town of Wheeler
(distance) miles (direction) of (nearest town)

WELL PURPOSE: Community
(home, irrigation, municipal, industrial)

- WELL COMPLETION DATA:
- (1) diameter (inches) 10 x 6
 - (2) total depth (feet) 404.7
 - (3) static water level (feet) 50 below top of ground
 - (4) casing Steel 330 (material), (depth)
10 (size) if telescope see back.
 - (5) screen 72 332.7 (length), (depth to top)
6 S.S. slot (size), (material)
 - (6) pump 25 244 (HP), (yield gpm)
Elec. (type power)
 - (7) electric log yes (yes or no)
USGS (organization running log)
 - (8) how well bottom plugged BWV 6 Bronze

description of formations encountered	from	to
	0	10
Red Clay	0	10
Coarse Sand	10	18
Blue Clay	18	21
Hard Rock	21	23
Blue Clay	23	27
Sandy Clay	27	50
Blue Clay	50	70
Sand	70	90
Blue Clay	90	100
Sand	100	190
Hard Rock	190	192
Sandy Clay	192	260
Sand	260	420
Gravel	420	440

CODED

RECEIVED
MAR - 6 1975


DRILLERS REMARKS:

R COMM



If well telescopes please sketch and show depths.

GROUND LEVEL

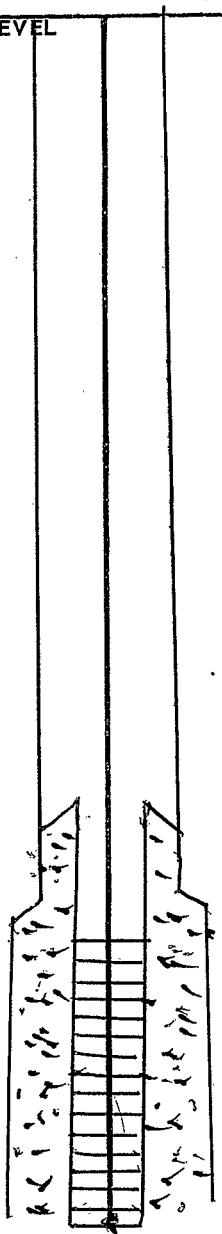

330'
10" casing
Static W/L 50'
DD 89'
244 GPM
2.7 GPF

72'
6" Screen
.030

X			

SECTION 7

Please indicate well location X.

ADDITIONAL INFORMATION

170' col. 5"
25HP motor

If more than one screen, show locations of each on sketch.