

PRENTISS
K 7881
10-7-74

MISSISSIPPI
BOARD OF WATER COMMISSIONERS
416 North State Street
Jackson, Mississippi 39201

CODED

WATER WELL DRILLERS LOG


10-7
date well completed

1974 Bonds Well Drilling
firm name

Prentiss
county well located

LANDOWNER: <u>Larry Sifers</u> <u>Bonville</u> <u>Mias</u> (mailing address)	description of formations encountered	from	to
	<u>Red Clay</u>	<u>0</u>	<u>14</u>
	<u>Blue Clay</u>	<u>14</u>	<u>313</u>
	<u>Water Sand</u>	<u>313</u>	<u>365</u>
<p>WELL LOCATION: sec. <u>25</u> T. <u>6</u> N. R. <u>7</u> E. ^{13B} <u>7</u> miles <u>S</u> of <u>Bonville</u> (distance) (direction) (nearest town)</p> <p>WELL PURPOSE: <u>Home</u> (home, irrigation, municipal, industrial)</p> <p>WELL COMPLETION DATA:</p> <p>(1) diameter (inches) <u>4"</u></p> <p>(2) total depth (feet) <u>365</u></p> <p>(3) static water level (feet) <u>160</u> ^{below} above top of ground.</p> <p>(4) casing <u>Steel</u>, <u>18 1/2</u> (material) (depth)</p> <p>_____ If telescope see back. (size)</p> <p>(5) screen <u>None</u> (length) (depth to top)</p> <p>_____ (size) _____ (material)</p> <p>(6) pump <u>3/4</u> <u>10</u> (HP) (yield gpm)</p> <p><u>Sub</u> (type power)</p> <p>(7) electric log <u>NO</u> (yes or no)</p> <p>_____ (organization running log)</p> <p>(8) how well bottom plugged <u>open</u></p> <p>DRILLERS REMARKS:</p>			

CODED

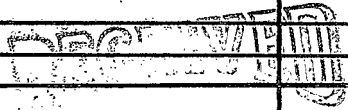


MAY 13 1975

MISSISSIPPI BOARD OF WATER COMMISSIONERS

COMMISSIONER

If well telescopes please :
sketch and show depths.

GROUND LEVEL

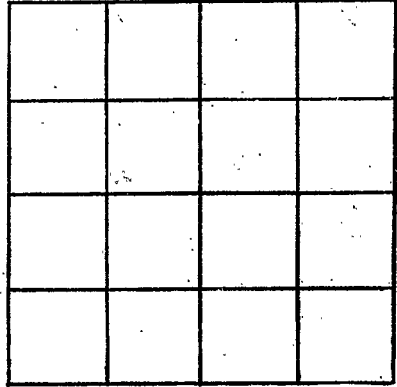

SECTION _____

Please indicate well location X.

ADDITIONAL INFORMATION

If more than one screen,
show locations of each on sketch.