

Prentiss
K 88
3-19-75

MISSISSIPPI
 BOARD OF WATER COMMISSIONERS
 416 North State Street
 Jackson, Mississippi 39201

CODED

WATER WELL DRILLERS LOG

3-19-75 19 Booneville Drilling Prentiss
 date well completed firm name county well located

LANDOWNER: John Woodruff
Booneville, Miss.
 (mailing address)

description of formations encountered	from	to
	<u>Red clay</u>	<u>0</u>
<u>Blue clay</u>	<u>33</u>	<u>290</u>
<u>Water Sand</u>	<u>290</u>	<u>332 1/2</u>

WELL LOCATION:
 sec 15 T 6 N R 7 E ¹³⁸
7 miles ^S South of Booneville
 (distance) (direction) (nearest town)

WELL PURPOSE: Home
 (home, irrigation, municipal, industrial)

- WELL COMPLETION DATA:
- (1) diameter (inches) 4"
 - (2) total depth (feet) 332 1/2
 - (3) static water level (feet) 160 ^{below} _{above} top of ground.
 - (4) casing Steel, 42,
 (material) (depth)
 (size) If telescope see back.
 - (5) screen None,
 (length) (depth to top)
 (size) (material)
 - (6) pump Subm., 6
 (HP) (yield gpm)
Elect.
 (type power)
 - (7) electric log NO
 (yes or no)
 (organization running log)
 - (8) how well bottom plugged open


CODED

DRILLERS REMARKS:

RECEIVED
 SEP 24 1975

If well telescopes please sketch and show depths.

GROUND LEVEL

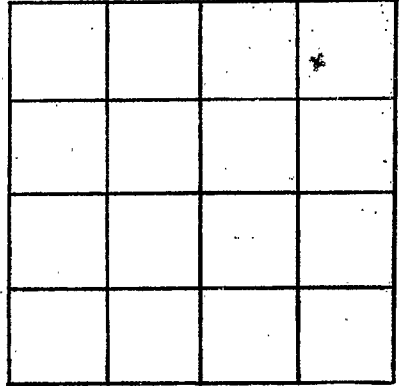

SECTION _____

Please indicate well location X.

ADDITIONAL INFORMATION

If more than one screen,
show locations of each on sketch.