

Prentiss

K

7-11-60

WATER WELL DRILLERS LOG

K300

Prentiss

Date: 7-11, 1960, Driller: O. C. Webb County: Prentiss

(Name)

	Description & Color of Materials Sand, Clay, Red Clay, Shell, etc.	Thick- ness Feet	Depth Feet
(1) Owner of Land: <u>Ellis W. Williams</u> (Name) <u>Wheeler</u> <u>Miss</u> (Address)	<u>Sand to 30ft</u>		
(2) Location: <u>1/4</u> , <u>1/4</u> , Sec. <u> </u> T <u> </u> R <u> </u> <u>1/2</u> miles <u>East</u> of <u>Wheeler</u> (distance) (direction) (Nearest Town)	<u>hard Rock</u>		
(3) Topography: <u> </u> (Hilly) (Flat) (Level)	<u>2ft sand</u>		
(4) Purpose of Well: <u> </u> (Domestic Irrigation Municipal, Industrial, Other)	<u>to 35ft Blue</u>		
	<u>Rock to 165</u>		
	<u>ft water sand</u>		
	<u>to 230ft</u>		


Information upon completion of well:

- (1) Diameter 4 inches.
- (2) Total Depth 230 feet.
- (3) Water Level 60 feet below top of ground.
- (4) Cased to 42, Size 4".
- (5) Screen: Size 0, Length .
- (6) Were any formations sealed against pollution?
 yes, 0 no.

If YES depth of formation

Why

Drillers Remarks:

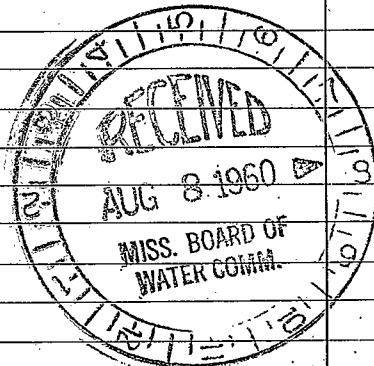

(Use Back Side)

Well No.
K300

1. The first part of the document is a list of names and addresses.

2. The second part is a list of names and addresses.

3. The third part is a list of names and addresses.

4. The fourth part is a list of names and addresses.

5. The fifth part is a list of names and addresses.

6. The sixth part is a list of names and addresses.

7. The seventh part is a list of names and addresses.

8. The eighth part is a list of names and addresses.

9. The ninth part is a list of names and addresses.