

PRENTISS

MISSISSIPPI

WATER

COMMISSIONERS

K301

K

WATER WELL DRILLERS LOG

Herndon, V. & Supply Co.

SHANNON, MISS.

Prentiss

9-13-60

Date: Sept 13, 1960, Driller:

County Lee

(Name.....)

- (1) Owner of Land: Boyd Owens
(Name)
Wheeler Miss.
(Address)
- (2) Location: 1/4, 1/4, Sec. T. R.
 miles , of Wheeler
(distance) (direction) (Nearest Town)
- (3) Topography: Flat
(Hilly) (Flat) (Level)
- (4) Purpose of Well: Home use
(Domestic Irrigation
Municipal, Industrial, Other)


Description & Color of Materials Sand, Clay, Red Clay, Shell, etc.	Thick- ness Feet	Depth Feet.
<u>Sand & Clay</u>		<u>20</u>
<u>Blue Shale</u>		<u>70</u>
<u>Sand</u>		<u>40</u>
<u>Bottom</u>		<u>96</u>

Information upon completion of well:

- (1) Diameter 4" inches.
- (2) Total Depth 94 feet.
- (3) Water Level feet below top of ground.
- (4) Cased to 21 ft, Size 4 in.
- (5) Screen: Size , Length
- (6) Were any formations sealed against pollution?
X yes, no.

If YES depth of formation 21 ft
Why Surface & Sand

Drillers Remarks:

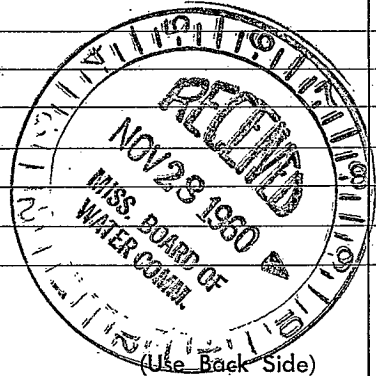

Well No.

