

PRENTISS MISSISSIPPI BOARD OF WATER COMMISSIONERS

K 2000
7-2-65

WATER WELL DRILLERS LOG

Date: July 2, 1965, Driller: Herndon-Homan Well & Pump Co., Inc. Prentiss

Name: Box 42

SHANNON, MISSISSIPPI 38360

(1) Owner of Land: Vance Garne
(Name)
Wheeler, Miss.
(Address)

(2) Location: 1/4, 1/4, Sec. 7 T 6S R 17E
_____ miles _____ of Wheeler
(distance) (direction) (Nearest Town)

(3) Topography: Flat
(Hilly) (Flat) (Level)

(4) Purpose of Well: Domestic
(Domestic Irrigation
Municipal, Industrial, Other)

Description & Color of Materials Sand, Clay, Red Clay, Shell, etc.	Thick- ness Feet	Depth Feet
<u>yellow sand & clay</u>	<u>0</u>	<u>35</u>
<u>Blue clay</u>	<u>35</u>	<u>530</u>
<u>sand</u>	<u>130</u>	<u>138</u>
<u>Blue clay</u>	<u>158</u>	<u>180</u>
<u>Sand</u>	<u>180</u>	<u>300</u>

Information upon completion of well:

(1) Diameter 5 inches.

(2) Total Depth 300 feet.

(3) Water Level 20' feet below top of ground.

(4) Cased to 162', Size 5"


(5) Screen: Size 2", Length 20'

(6) Were any formations sealed against pollution?
yes, _____ no.

If YES depth of formation 158'

Why sulfur & sand

Drillers Remarks:

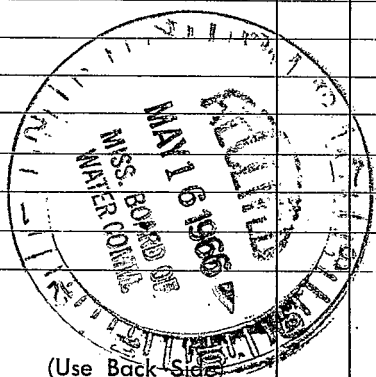

Well No.

(Use Back Side)

[The page contains extremely faint and illegible text, likely bleed-through from the reverse side of the document. No specific words or phrases can be discerned.]